

HARRISON  
M 2133  
7-20-76

MISSISSIPPI  
BOARD OF WATER COMMISSIONERS  
416 North State Street  
138 Jackson, Mississippi 39201

WATER WELL DRILLERS LOG

*Harrison*

July 20  
date well completed

1976 HARRISON COUNTY  
firm name


McGill Well Work Inc  
county well located

LANDOWNER: <u>O.D. MILLER.</u>	description of formations encountered	from	to
<u>915 - 23<sup>RD</sup> SE.</u> <u>GLF, MS.</u> (mailing address)			
<b>WELL LOCATION:</b>			
sec. <u>22</u> T <u>2</u> N R <u>10</u> E <u>4</u> miles <u>E.</u> of <u>GLF.</u> (distance) (direction) (nearest town)			
<b>WELL PURPOSE:</b> <u>CAWN</u> (home, irrigation, municipal, industrial)			
<b>WELL COMPLETION DATA:</b>			
(1) diameter (inches) <u>2"</u>			
(2) total depth (feet) <u>30'</u>			
(3) static water level (feet) <u>3'</u> <u>below</u> top of ground.			
(4) casing <u>Sch 40 PVC. 20'</u> (material) (depth)			
<u>—</u> If telescope see back. (size)			
(5) screen <u>10'</u> (length) (depth to top)			
<u>2"</u> <u>PLASTIC</u> (size) (material)			
(6) pump <u>1/2</u> <u>14</u> (HP) (yield gpm)			
<u>Electric</u> (type power)			
(7) electric log <u>NO</u> (yes or no)			
<u>—</u> (organization running log)			
(8) how well bottom plugged <u>CAPPED</u>			
<b>DRILLERS REMARKS:</b>			

**RECEIVED**  
JAN 27 1977

If well telescopes please sketch and show depths.

GROUND LEVEL

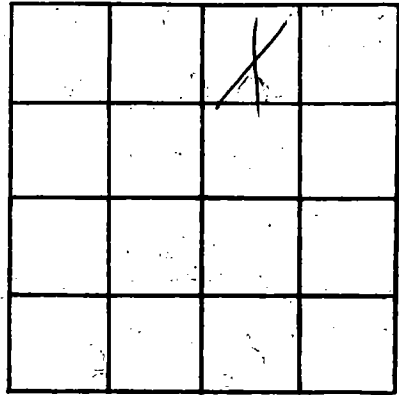

SECTION

32

Please indicate well location X.

ADDITIONAL INFORMATION

If more than one screen, show locations of each on sketch.