

HARRISON
 M 2138
 7-27-76

MISSISSIPPI
 BOARD OF WATER COMMISSIONERS
 416 North State Street
 Jackson, Mississippi 39201

WATER WELL DRILLERS LOG

7-27-1976 *McGee well works* *Harrison*
 date well completed firm name county well located

LANDOWNER: *John Blake*
2414 Middlecott Dr.
Hgt. mo.
 (mailing address)

description of formations encountered	from	to
	<i>Sand</i>	<i>0</i>

WELL LOCATION:
 sec 32 T 7 N R 10 E
4 miles E of Hgt
 (distance) (direction) (nearest town)

WELL PURPOSE: *water*
 (home, irrigation, municipal, industrial)

- WELL COMPLETION DATA:
- (1) diameter (inches) 2"
 - (2) total depth (feet) 30'
 - (3) static water level (feet) 3' below top of ground.
 - (4) casing sch. 40 20'
 (material) (depth)
 - If telescope see back.
 (size)
 - (5) screen 10' —
 (length) (depth to top)
2" plastic
 (size) (material)
 - (6) pump 1/2 14
 (HP) (yield gpm)
electric
 (type power)
 - (7) electric log no
 (yes or no)
 - (organization running log)
 - (8) how well bottom plugged Capped


DRILLERS REMARKS:

RECEIVED
 FEB 14 1977

MISS. BD. OF WATER COM.

If well telescopes please
sketch and show depths.

GROUND LEVEL

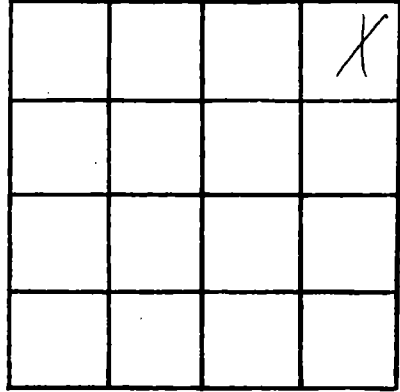

SECTION 32

Please indicate well location X.

ADDITIONAL INFORMATION

If more than one screen,
show locations of each on sketch.