

HARRISON
M 2139
7-27-76

MISSISSIPPI
BOARD OF WATER COMMISSIONERS
416 North State Street
Jackson, Mississippi 39201

WATER WELL DRILLERS LOG

7-27-1976 date well completed
McGee well works firm name
Harrison county well located


LANDOWNER: <u>Myra Gibbs</u> <u>5 Lexington Place</u> <u>Hgt, Miss.</u> (mailing address)	description of formations encountered	from to
	<u>sand</u>	<u>0 30</u>
WELL LOCATION: sec <u>22</u> T <u>7</u> N R <u>10</u> E <u>4</u> miles <u>E</u> of <u>Hgt.</u> (distance) (direction) (nearest town)		
WELL PURPOSE: <u>drinking</u> (home, irrigation, municipal, industrial)		
WELL COMPLETION DATA:		
(1) diameter (inches) <u>2"</u>		
(2) total depth (feet) <u>30'</u>		
(3) static water level (feet) <u>3'</u> <u>below</u> top of ground.		
(4) casing <u>sch. 40</u> <u>20'</u> (material) (depth)		
<u>—</u> (size) if telescope see back.		
(5) screen <u>10'</u> <u>—</u> (length) (depth to top)		
<u>2"</u> <u>plastic</u> (size) (material)		
(6) pump <u>1/2</u> <u>14</u> (HP) (yield gpm)		
<u>electric</u> (type power)		
(7) electric log <u>no</u> (yes or no)		
<u>—</u> (organization running log)		
(8) how well bottom plugged <u>capped</u>		
DRILLERS REMARKS:		

RECEIVED
FEB 14 1977

MISS. BD. OF WATER COMMISSIONERS

If well telescopes please sketch and show depths.

GROUND LEVEL

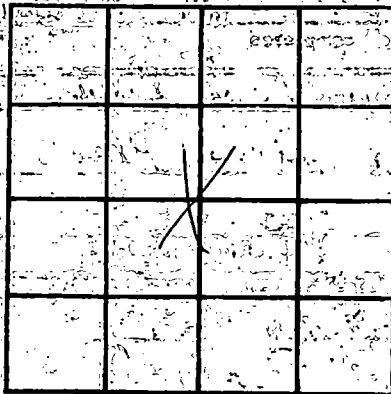

SECTION

32

Please indicate well location X.

ADDITIONAL INFORMATION

If more than one screen, show locations of each on sketch.