

HARRISON
M 2140
7-27-76

MISSISSIPPI
BOARD OF WATER COMMISSIONERS
416 North State Street
Jackson, Mississippi 39201

WATER WELL DRILLERS LOG

7-27-1976 date well completed
Mc Hill well works Harrison firm name
Harrison county well located

LANDOWNER: Ashton Richard
242 Middlecoff Dr.
Hgt. Mo.
(mailing address)

description of formations encountered	from	to
	sand	0

WELL LOCATION:
sec. 32 T 7 N R 10 E
4 miles E of Hgt.
(distance) (direction) (nearest town)

WELL PURPOSE: Lawn
(home, irrigation, municipal, industrial)

- WELL COMPLETION DATA:
- (1) diameter (inches) 2"
 - (2) total depth (feet) 30'
 - (3) static water level (feet) 3' below top of ground.
 - (4) casing Sch. 40, 20' (material), (depth)
 - (5) screen 10' (length), (depth to top)
2" (size), plastic (material)
 - (6) pump 1/2 (HP), 14 (yield gpm)
electric (type power)
 - (7) electric log no (yes or no)
 - (8) how well bottom plugged capped.


DRILLERS REMARKS:

RECEIVED
FEB 14 1977

MISS. BD. OF WATER COMM.

If well telescopes please sketch and show depths.

GROUND LEVEL

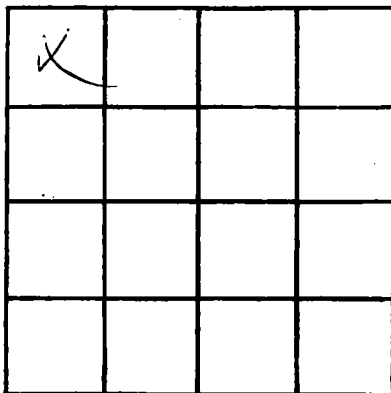

SECTION 32

Please indicate well location X.

ADDITIONAL INFORMATION

A series of horizontal lines for writing additional information.

If more than one screen, show locations of each on sketch.