

HARRISON
 M 2142
 7-28-76

MISSISSIPPI
 BOARD OF WATER COMMISSIONERS
 416 North State Street
 Jackson, Mississippi 39201

WATER WELL DRILLERS LOG

7-28-1976 *Mc Hill Well Works* *Harrison*
 date well completed firm name county well located

LANDOWNER: *John Palmer*
2415 Middlecoff
Hgt. Mo.
 (mailing address)

description of formations encountered	from	to
	<i>sand</i>	<i>0</i>

WELL LOCATION:
 sec. 32 T. 7 N. R. 10 E.
4 miles E. of Hgt.
 (distance) (direction) (nearest town)

WELL PURPOSE: *lawn*
 (home, irrigation, municipal, industrial)

- WELL COMPLETION DATA:
- (1) diameter (inches) 2"
 - (2) total depth (feet) 30'
 - (3) static water level (feet) 3' ^{below} above top of ground.
 - (4) casing sch. 40, 20'
 (material) (depth)
 - If telescope see back.
 (size)
 - (5) screen 10', —
 (length) (depth to top)
2", plastic
 (size) (material)
 - (6) pump 1/2, 14
 (HP) (yield gpm)
electric
 (type power)
 - (7) electric log NO
 (yes or no)
 - (organization running log)
 - (8) how well bottom plugged Capped


DRILLERS REMARKS:

RECEIVED
 FEB 14 1977

MISS. BD. OF WATER COMM.

If well telescopes please sketch and show depths.

GROUND LEVEL

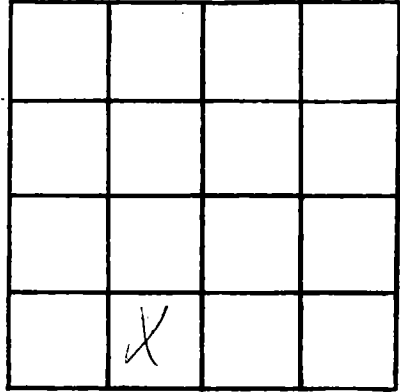

SECTION 32

Please indicate well location X.

ADDITIONAL INFORMATION

If more than one screen, show locations of each on sketch.