

HARRISON
 M 2154
 8/9/76
 8/9/76
 date well completed

MISSISSIPPI
 BOARD OF WATER COMMISSIONERS
 416 North State Street
 Jackson, Mississippi 39201

WATER WELL DRILLERS LOG
 COASTAL DRILLING & SERVICE CO.

ROUTE 1 BOX 618
 BILBO, MISSISSIPPI

Harrison
 county well located

LANDOWNER: *J. L. Husky*

description of formations encountered

from to

J. L. Husky Rt 1
Bilbo, Miss 39532
 (mailing address)

Top Soil	1	5
Red Clay	5	15
White Sand	15	40
Soft Blue Clay	40	80
White Sand	80	100
Soft Blue Clay	100	130
Hard Blue Clay	130	240
fine water sand	240	260
hard blue clay	260	275
fine water sand	275	300
Coarse water sand	300	325

WELL LOCATION:

sec. 3 T 7 N R. 10 E
Woodworth
 (distance) (direction) (nearest town)

WELL PURPOSE: *home*
 (home, irrigation, municipal, industrial)

WELL COMPLETION DATA:

- (1) diameter (inches) 2"
- (2) total depth (feet) 325'
- (3) static water level (feet) 30 below top of ground.
- (4) casing PVC, 315'
 (material) (depth)
 (size) if telescope see back.
- (5) screen 10', 315'
 (length) (depth to top)
2", PVC
 (size) (material)
- (6) pump One, 12
 (HP) (yield gpm)
Ed
 (type power)
- (7) electric log no
 (yes or no)
 (organization running log)

(8) how well bottom plugged
2" wood with water


DRILLERS REMARKS:
none

RECEIVED
 AUG 27 1976

MISS. BD. OF WATER COMMISSIONERS

If well telescopes please sketch and show depths.

GROUND LEVEL

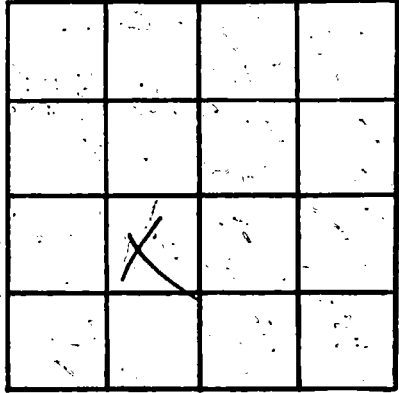

SECTION _____

Please indicate well location X.

ADDITIONAL INFORMATION

If more than one screen,
show locations of each on sketch.