

HARRISON
M 2155
8/9/76

MISSISSIPPI
BOARD OF WATER COMMISSIONERS
416 North State Street
Jackson, Mississippi 39201

WATER WELL DRILLERS LOG
COASTAL DRILLING & SERVICE CO.

8/19/76
date well completed

ROUTE 1 BOX 628

Harrison
county well located

LANDOWNER: William E. Ellens
Biloxi, Miss. 39532

description of formations encountered	from	to
Top Soil	0	5
Red Clay	5	15
White Sand	15	40
Soft Blue Clay	40	80
White Sand	80	100
Soft Blue Clay	100	130
Hard Blue Clay	130	240
fine water sand	240	260
Hard Blue Clay	260	275
fine water sand	275	300
Coarse water sand	300	325

Bill Ellens
Rt 1 Biloxi, Miss
(mailing address)

WELL LOCATION:

sec. 3 T 7 N R. 10 E
S W
Woodmarket
(distance) miles (direction) of (nearest town)

WELL PURPOSE: home
(home, irrigation, municipal, industrial)

WELL COMPLETION DATA:

- (1) diameter (inches) 2"
 - (2) total depth (feet) 325
 - (3) static water level (feet) 40 below above top of ground.
 - (4) casing PVC, 315'
(material) (depth)
(size) if telescope see back.
 - (5) screen 10 315'
(length) (depth to top)
2" PVC
(size) (material)
 - (6) pump One 12
(HP) (yield gpm)
Ele
(type power)
 - (7) electric log no
(yes or no)
- (organization running log)


(8) how well bottom plugged
Block with blue
DRILLERS REMARKS
none

RECEIVED
AUG 27 1976

MISS. RD. OF WATER COMM

If well telescopes please sketch and show depths.

GROUND LEVEL

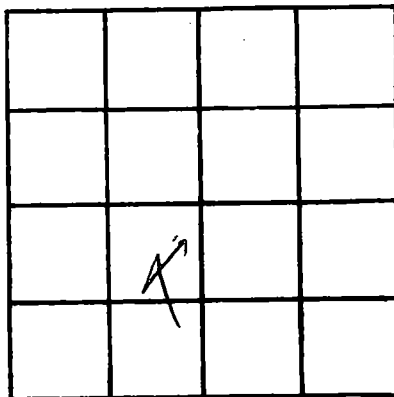

SECTION _____

Please indicate well location X.

ADDITIONAL INFORMATION

If more than one screen, show locations of each on sketch.