

HARRISON  
M 2174  
8/18/76

MISSISSIPPI  
BOARD OF WATER COMMISSIONERS  
416 North State Street  
Jackson, Mississippi 39201

WATER WELL DRILLERS LOG

8-18-1976 date well completed  
McGill Well Works firm name  
Harrison county well located

LANDOWNER: Margaret Taylor  
1701 - 24th St.  
Dept, Mo.  
(mailing address)

description of formations encountered	from	to
	<u>sand</u>	<u>0</u>

WELL LOCATION:  
sec. 32 T 7 N R 10 E  
4 miles E of Dept  
(distance) (direction) (nearest town)

WELL PURPOSE: Lawn  
(home, irrigation, municipal, industrial)

- WELL COMPLETION DATA:
- (1) diameter (inches) 2"
  - (2) total depth (feet) 30'
  - (3) static water level (feet) 2' <sup>below</sup> above top of ground.
  - (4) casing sch. 40 PK 20'  
(material) (depth)
  - if telescope see back.  
(size)
  - (5) screen 10' -  
(length) (depth to top)
  - 2" plastic  
(size) (material)
  - (6) pump 1/2 14  
(HP) (yield gpm)
  - electric  
(type power)
  - (7) electric log no  
(yes or no)
  - (organization running log)
  - (8) how well bottom plugged Capped


DRILLERS REMARKS:

RECEIVED  
FEB - 9 1977

MISS. BD. OF WATER COMM

If well telescopes please sketch and show depths.

GROUND LEVEL

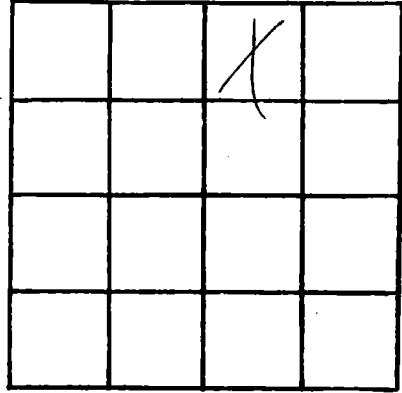

SECTION 22

Please indicate well location X.

ADDITIONAL INFORMATION

If more than one screen, show locations of each on sketch.