

HARRISON
M 2180
8-23-76

MISSISSIPPI
 BOARD OF WATER COMMISSIONERS
 416 North State Street
 Jackson, Mississippi 39201

WATER WELL DRILLERS LOG

8-23-1976 date well completed
 McHie Well Works Harrison firm name
 Harrison county well located

LANDOWNER: Amel Taylor
2300 Farrell Blvd.
Hel. Mo.
 (mailing address)

description of formations encountered	from to	
	ft	ft
<u>sand</u>	<u>0</u>	<u>30</u>

WELL LOCATION:
 sec. 32 T 7 N R 10 E
4 miles E of Hel.
 (distance) (direction) (nearest town)

WELL PURPOSE: lawn
 (home, irrigation, municipal, industrial)

WELL COMPLETION DATA:

(1) diameter (inches) 2"

(2) total depth (feet) 30'

(3) static water level (feet) 3' below above top of ground.

(4) casing Pvc. sch. 40 20'
 (material) (depth)
— If telescope see back.
 (size)

(5) screen 10' (length) (depth to top)
2" (size) plastic (material)

(6) pump 1/2 (HP) 14 (yield gpm)
electric (type power)

(7) electric log no (yes or no)
— (organization running log)


(8) how well bottom plugged Capped

DRILLERS REMARKS:

RECEIVED
 FEB 11 1977

If well telescopes please sketch and show depths.

GROUND LEVEL

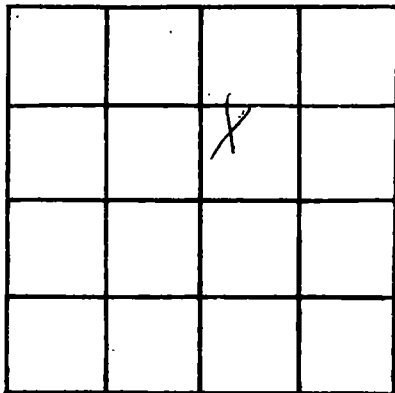

SECTION 32

Please indicate well location X.

ADDITIONAL INFORMATION

Lined area for additional information.

If more than one screen, show locations of each on sketch.