

HARRISON
M 2189
9-6-76

MISSISSIPPI
BOARD OF WATER COMMISSIONERS
416 North State Street
Jackson, Mississippi 39201

WATER WELL DRILLERS LOG

Sept. 6 - 1976 ¹³⁵ McBill Well Works INC. HARRISON
date well completed firm name county well located

LANDOWNER: 295 Pinewood Cir. description of formations encountered from to
THOMAS HOAGAN SAND. 0 30
OLF, MS. (mailing address)

WELL LOCATION:
sec. 32 T 7 N R 10 E
4 miles E of OLF.
(distance) (direction) (nearest town)

WELL PURPOSE: LAWN
(home, irrigation, municipal, industrial)


- WELL COMPLETION DATA:
- (1) diameter (inches) 2"
 - (2) total depth (feet) 30'
 - (3) static water level (feet) 3' ^{below} ~~above~~ top of ground.
 - (4) casing Sch. 40 PVC, 20' (material) (depth)
(size) If telescope see back.
 - (5) screen 10" (length) (depth to top)
2" (size) plastic (material)
 - (6) pump 1/2 (HP) 14 (yield gpm)
electric (type power)
 - (7) electric log NO (yes or no)
(organization running log)
 - (8) how well bottom plugged CAPPED.

DRILLERS REMARKS:

RECEIVED
JAN 27 1977

If well telescopes please sketch and show depths.

GROUND LEVEL

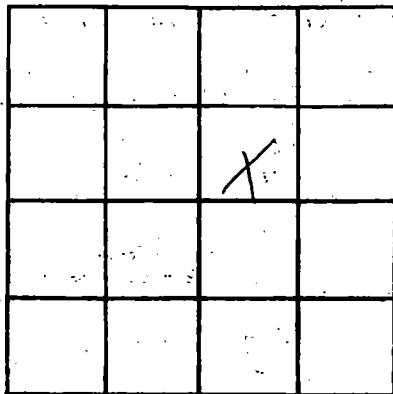

SECTION 32

Please indicate well location X.

ADDITIONAL INFORMATION

If more than one screen,
show locations of each on sketch.