

HARRISON
M 2190
9-8-76

MISSISSIPPI
BOARD OF WATER COMMISSIONERS
416 North State Street
135 Jackson, Mississippi 39201

WATER WELL DRILLERS LOG

SEPT-8-1976 McGILL Wellworks HARRISON
date well completed firm name county well located

LANDOWNER: A. J. FAURE JR
227 PINEWOOD CIR
Gulf, MS.
(mailing address)

description of formations encountered	from	to
	SAND	0

WELL LOCATION:
sec. 32 T 7 N R 10 E
4 miles E of Gulf.
(distance) (direction) (nearest town)

WELL PURPOSE: drain
(home, irrigation, municipal, industrial)

- WELL COMPLETION DATA:
- (1) diameter (inches) 2"
 - (2) total depth (feet) 30'
 - (3) static water level (feet) 3' below above top of ground.
 - (4) casing SCH 40 PIP 20'
(material) (depth)
 - if telescope see back.
(size)
 - (5) screen 10'
(length) (depth to top)
 - 2" PLASTIC
(size) (material)
 - (6) pump 1/2 14
(HP) (yield gpm)
 - electric
(type power)
 - (7) electric log NO
(yes or no)
 - (organization running log)
 - (8) how well bottom plugged CAPPED.


DRILLERS REMARKS:

RECEIVED
JAN 27 1977

MISS. Bd. of Water Comm.

If well telescopes please sketch and show depths.

GROUND LEVEL

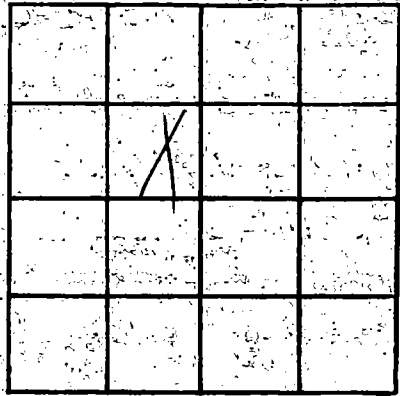

SECTION 32

Please indicate well location X.

ADDITIONAL INFORMATION

If more than one screen, show locations of each on sketch.