

HARRISON  
M 2192  
9-15-76

MISSISSIPPI  
 BOARD OF WATER COMMISSIONERS  
 416 North State Street  
 Jackson, Mississippi 39201

WATER WELL DRILLERS LOG

Sept. 15 1976 McBill Well Works HARRISON  
 date well completed firm name county well located

LANDOWNER: W.D. NEWMAN  
3718 - 9th St.  
BIF, Ms.  
 (mailing address)

description of formations encountered	from	to
	<u>SAND.</u>	<u>0</u>

WELL LOCATION:  
 sec 32 T 7 N R 10 E  
4 miles E of GLF  
 (distance) (direction) (nearest town)

WELL PURPOSE: Lawn  
 (home, irrigation, municipal, industrial)


- WELL COMPLETION DATA:
- (1) diameter (inches) 2"
  - (2) total depth (feet) 30'
  - (3) static water level (feet) 3' below above top of ground.
  - (4) casing SAPHOPIC, 20'  
 (material) (depth)  
— If telescope see back.  
 (size)
  - (5) screen 10', —  
 (length) (depth to top)  
2", PLASTIC  
 (size) (material)
  - (6) pump 1/2, 160  
 (HP) (yield gpm)  
ELECTRIC  
 (type power)
  - (7) electric log NO  
 (yes or no)  
—  
 (organization running log)
  - (8) how well bottom plugged CLAPPED.

DRILLERS REMARKS: \_\_\_\_\_

**RECEIVED**  
 JAN 27 1977

If well telescopes please sketch and show depths.

GROUND LEVEL

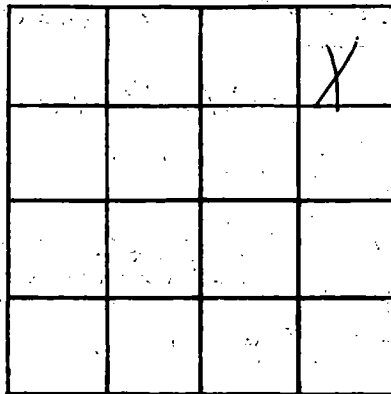

SECTION 32

Please indicate well location X.

**ADDITIONAL INFORMATION**

Lined area for additional information.

If more than one screen, show locations of each on sketch.