

HARRISON  
M 2196  
10/1/76

MISSISSIPPI  
 BOARD OF WATER COMMISSIONERS  
 416 North State Street  
 Jackson, Mississippi 39201

139

WATER WELL DRILLERS LOG

Oct. 1 1976 McGill well works Harrison  
 date well completed firm name county well located

LANDOWNER: R.A. Wiley,  
517 Lewis Ave  
Hy. Mo.  
 (mailing address)

description of formations encountered	from	to
<u>Sand</u>	<u>0</u>	<u>30</u>

WELL LOCATION:  
 sec. 32 T. 7 N. R. 10 E.  
4 miles E of Hy.  
 (distance) (direction) (nearest town)

WELL PURPOSE: Lawn  
 (home, irrigation, municipal, industrial)

- WELL COMPLETION DATA:
- (1) diameter (inches) 2"
  - (2) total depth (feet) 30'
  - (3) static water level (feet) 3' below top of ground
  - (4) casing PVC sch 40 (material) 20' (depth)
  - If telescope see back. (size)
  - (5) screen 10' (length) — (depth to top)
  - 2" (size) plastic (material)
  - (6) pump 1/2 (HP) electric (yield gpm) 14
  - electric (type power)
  - (7) electric log no (yes or no)
  - (organization running log)
  - (8) how well bottom plugged capped


DRILLERS REMARKS: —

**RECEIVED**  
 JAN 27 1977

MISS. BD. OF WATER COMM

If well telescopes please sketch and show depths.

GROUND LEVEL

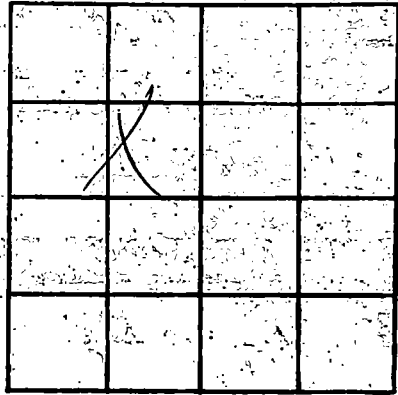

SECTION

32

Please indicate well location X.

ADDITIONAL INFORMATION

Multiple horizontal lines for providing additional information.

If more than one screen, show locations of each on sketch.