

HARRISON
 M 2201
 11-9-76

MISSISSIPPI
 BOARD OF WATER COMMISSIONERS
 416 North State Street
 Jackson, Mississippi 39201

WATER WELL DRILLERS LOG
 COASTAL DRILLING & SERVICE CO.

11/9/76
 date well completed

ROUTE 1 BOX 618
 firm name

Harrison
 county well located

LANDOWNER: *Manne Phelps*

Description of formations encountered	from	to
top soil	1	3
Red Clay	3	18
white sand	18	40
gray sand	40	80
light blue clay	80	235
fine water sand	235	260
hard blue clay	260	420
fine water sand	420	430
Clay (Bogal)	430	435
fine water sand	435	445
hard blue clay	445	570
fine white sand	570	570
Coarse water sand	570	570

P.O. Box 100
 Biloxi, Miss.
 (mailing address)

WELL LOCATION:
 sec. 12 T. 7 N R. 10 E
 0.9 miles South of Clontake
 (distance) (direction) (nearest town)

WELL PURPOSE: *Sanitation*
 (home, irrigation, municipal, industrial)

WELL COMPLETION DATA:

- (1) diameter (inches) 2 1/4"
- (2) total depth (feet) 570'
- (3) static water level (feet) 60 below top of ground.
- (4) casing PVC, 555'
 (material) (depth)
4x2" if telescope see back.
 (size)
- (5) screen 15', 555'
 (length) (depth to top)
- 2" (size) PVC (material)
- (6) pump Oneal 20
 (HP) (yield gpm)
Ele (type power)
- (7) electric log no
 (yes or no)

(organization running log)

(8) how well bottom plugged 2"
black water valve

DRILLERS REMARKS:

RECEIVED
 FEB - 4 1977

MISSISSIPPI BOARD OF WATER COMMISSIONERS

If well telescopes please sketch and show depths.

GROUND LEVEL


160' 4" PVC
Casing

39.5' 2" PVC
Casing

15' 2" PVC Screen

2" hook wash valve

If more than one screen,
show locations of each on sketch.

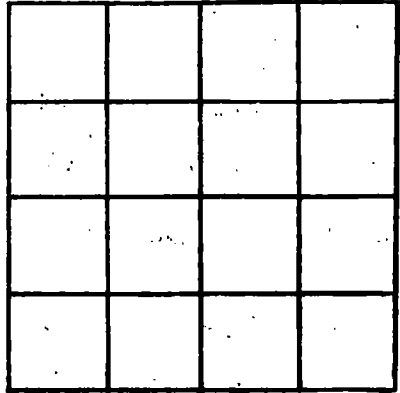

SECTION _____

Please indicate well location X.

ADDITIONAL INFORMATION

A series of horizontal lines for recording additional information, starting below the 'ADDITIONAL INFORMATION' header and extending to the bottom of the page.