

HARRISON
 M 2804
 2/9/77

MISSISSIPPI
 BOARD OF WATER COMMISSIONERS
 416 North State Street
 Jackson, Mississippi 39201

WATER WELL DRILLERS LOG

Harrison
~~Jackson~~
 county well located

2-9
 date well completed

1977 COAST WATER WELL SERVICE
 firm name

LANDOWNER

L. A. Contracting Co.

Description of formations encountered

from to

P. O. Box 639

Top soil

0 25

Hawthorn, Miss. 39553
 (mailing address)

Sand (coarse)

25 58

WELL LOCATION:

sec. 22 T 7 S R 10 W
 0.2 miles N of Biloxi
 (distance) (direction) (nearest town)

Blue Clay

58 60

Sand Gravel

60 76

WELL PURPOSE: Supply
 (home, irrigation, municipal, industrial)

Blue Clay

76 320

WELL COMPLETION DATA:

Sand (medium)

320 336

(1) diameter (inches) 2

Blue Clay

336 486

(2) total depth (feet) 532

Sand (medium)

486 532

(3) static water level (feet) 30' below top of ground.

(4) casing P.V.C. 522
 (material) (depth)

2 (size) if telescope see back.

(5) screen 12 522
 (length) (depth to top)

2 (size) P.V.C (material)

(6) pump 1 hp 8 1/2
 (HP) (yield gpm)

Select (type power)

(7) electric log No.
 (yes or no)

(organization running log)

(8) how well bottom plugged backwash
 Value


RECEIVED
 MAR - 9 1977

DRILLERS REMARKS:

WATER COMMISSIONERS

If well telescopes please sketch and show depths.

GROUND LEVEL

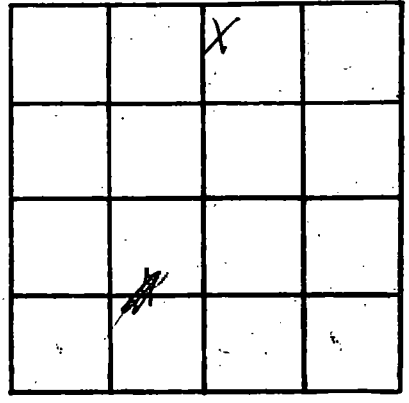

SECTION 22

Please indicate well location X.

ADDITIONAL INFORMATION

If more than one screen, show locations of each on sketch.