

HARRISON  
 M 2207  
 2/28/77

MISSISSIPPI  
 BOARD OF WATER COMMISSIONERS  
 416 North State Street  
 Jackson, Mississippi 39201

WATER WELL DRILLERS LOG

Feb. 28 1977 Duncan Well Drilling Harrison  
 date well completed firm name county well located


LANDOWNER: <u>John N. West Jr.</u>	description of formations encountered	from	to
<u>406 Singwood Drive</u> <u>Gulfport, Ms. 39501</u> (mailing address)	<u>SAND</u>	<u>0</u>	<u>17</u>
WELL LOCATION: sec <u>30</u> T <u>7</u> N <u>3</u> R <u>10</u> E <u>W</u> _____ miles _____ of <u>Gulfport</u> (distance) (direction) (nearest town)			
WELL PURPOSE: <u>LAWN</u> (home, irrigation, municipal, industrial)			
WELL COMPLETION DATA:			
(1) diameter (inches) <u>2"</u>			
(2) total depth (feet) <u>17</u>			
(3) static water level (feet) <u>4'</u> <u>below</u> top of ground. <u>above</u>			
(4) casing <u>PVC</u> <u>7</u> (material) (depth)			
<u>2"</u> If telescope see back. (size)			
(5) screen <u>10'</u> <u>7</u> (length) (depth to top)			
<u>2"</u> <u>PVC</u> (size) (material)			
(6) pump <u>1/2</u> <u>10</u> (HP) (yield gpm)			
<u>electric</u> (type power)			
(7) electric log _____ (yes or no)			
_____ (organization running log)			
(8) how well bottom plugged <u>Cap</u>			
DRILLERS REMARKS:			

RECEIVED

MAR 25 1977

If well telescopes please sketch and show depths.

GROUND LEVEL

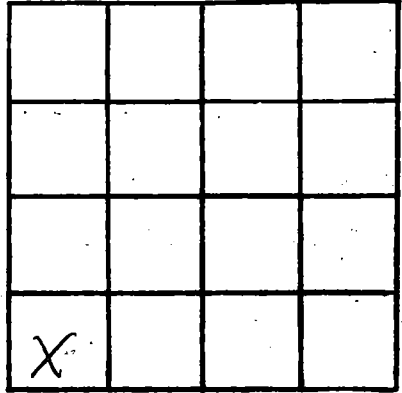

SECTION 30

Please indicate well location X.

ADDITIONAL INFORMATION

If more than one screen,  
show locations of each on sketch.