

HARRISON
M 2209
3-25-77

MISSISSIPPI
 BOARD OF WATER COMMISSIONERS
 416 North State Street
 135 Jackson, Mississippi 39201

WATER WELL DRILLERS LOG

March 25 19 77 Duncan Well Drilling Harrison
 date well completed firm name county well located

LANDOWNER: R. L. Supner
405 Singwood Dr.
Shufflet, Ms 39521
 (mailing address)

description of formations encountered	from	to
	<u>Sand</u>	<u>0</u>

WELL LOCATION:
 sec 30 T 1 N R 10 E
 (S) W
 _____ miles _____ of Shufflet
 (distance) (direction) (nearest town)

WELL PURPOSE: Lawn
 (home, irrigation, municipal, industrial)

WELL COMPLETION DATA:

(1) diameter (inches) 2"

(2) total depth (feet) 25

(3) static water level (feet) 4' below above top of ground.

(4) casing PVC 15
 (material) (depth)
 _____ If telescope see back.
 (size)

(5) screen 10' 15
 (length) (depth to top)
2" PVC
 (size) (material)

(6) pump 1/2 10
 (HP) (yield gpm)
electric
 (type power)

(7) electric log _____
 (yes or no)

 (organization running log)

(8) how well bottom plugged Cap


RECEIVED

MAR 25 1977

DRILLERS REMARKS: _____

If well telescopes please sketch and show depths.

GROUND LEVEL

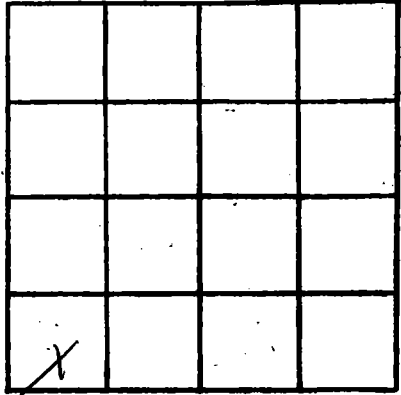

SECTION 30

Please indicate well location X.

ADDITIONAL INFORMATION

If more than one screen,
show locations of each on sketch.