

HARRISON
 M 2214
 4-19-77
 6/19/77
 date well completed

MISSISSIPPI
 BOARD OF WATER COMMISSIONERS
 416 North State Street
 Jackson, Mississippi 39201

WATER WELL DRILLERS LOG
 COASTAL DRILLING & SERVICE CO.

ROUTE 1 BOX 618

Harrison
 county well located

LANDOWNER: BILOXI, MISS

description of formations encountered	39532	
	from	to
top soil	1	3
yellow sand	3	3.5
5' blue clay	3.5	2.00
shell	2.00	2.05
fine water sand	2.05	2.55
fine water sand	2.55	2.70

James F. Debow
 6701 West Biloxi Way
 (mailing address)

WELL LOCATION:
 sec 17 T 7 N R 9 E
 (One) North Biloxi
 (distance) (direction) (nearest town)

WELL PURPOSE: home
 (home, irrigation, municipal, industrial)

WELL COMPLETION DATA:

- (1) diameter (inches) 2"
- (2) total depth (feet) 270'
- (3) static water level (feet) 40 below above top of ground.
- (4) casing PVC 260'
 (material) (depth)
- (5) screen 10' 260'
 (length) (depth to top)
2" PVC
 (size) (material)
- (6) pump One 15
 (HP) (yield gpm)
Ell
 (type power)
- (7) electric log no
 (yes or no)

(organization running log)

(By how well bottom plugged)
2' back with water


DRILLERS REMARKS:
Very Good Well

RECEIVED
 JUN 1 6 1977

MISS. BD. OF WATER COMMISSIONERS

If well telescopes please sketch and show depths.

GROUND LEVEL

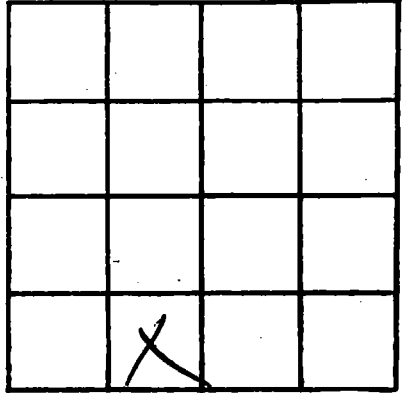

SECTION _____

Please indicate well location X.

ADDITIONAL INFORMATION

If more than one screen, show locations of each on sketch.