

HARRISON
M 2217
5/11/77

MISSISSIPPI
BOARD OF WATER COMMISSIONERS
416 North State Street
135 Jackson, Mississippi 39201

WATER WELL DRILLERS LOG

5/11/77 19 Central Drilling Harrison
date well completed firm name county well located
Bilal's, Inc.

LANDOWNER Vernon Mellett
RT 7 - Box 642
Bilal's, Inc.
(mailing address)

Description of formations encountered	from	to
Top Soil	4	4
Red Clay	4	15
Sugar Sand	15	30
Coarse white sand	30	80
Soft Blue Clay	80	165
fine water sand	165	190
Soft Blue Clay	190	285
fine water sand	285	320
hard Blue Clay	320	520
Shelly fine water sand	520	560
hard Blue Clay	560	705
fine water sand	705	715
Coarse water sand	715	765

WELL LOCATION:
sec. 9 T. 7 N. R. 9 E.
S. W.
1 1/2 miles North of Oshtemo
(distance) (direction) (nearest town)

WELL PURPOSE: home
(home, irrigation, municipal, industrial)

WELL COMPLETION DATA:
(1) diameter (inches) 4 1/2"
(2) total depth (feet) 765'
(3) static water level (feet) 20 below above top of ground.
(4) casing PVC 750'
(material) (depth)
4 1/2" If telescope see back.
(size)
(5) screen 15' 750'
(length) (depth to top)
2" PVC
(size) (material)
(6) pump One 20
(HP) (yield gpm)
Ele
(type power)
(7) electric log no
(yes or no)
(organization running log)

(8) how well bottom plugged
2 1/2 inch web valve

DRILLERS REMARKS:



NOV 28 1977

If well telescopes please sketch and show depths.

GROUND LEVEL


1160' 4" pk Casing

590' 2" pk Casing

15' 2" pk Screen

2" hub wash valve

If more than one screen, show locations of each on sketch.

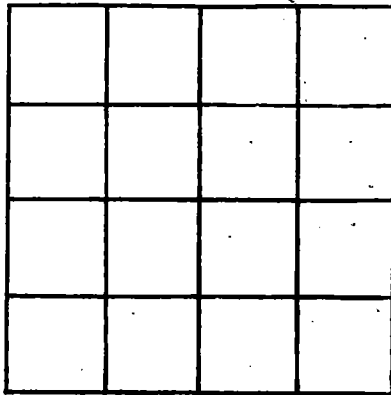

SECTION _____

Please indicate well location X.

ADDITIONAL INFORMATION

A series of horizontal lines for providing additional information.