

HARRISON
M 2221
5/25/77

MISSISSIPPI
BOARD OF WATER COMMISSIONERS
416 North State Street
Jackson, Mississippi 39201
135
WATER WELL DRILLERS LOG

May 25 1977 date well completed
1977 Mobile Well Works, Inc. firm name
Harrison county well located

LANDOWNER: John Balling
106 Dogwood Dr. Wagon
Hgt. Mo.
(mailing address)

description of formations encountered
sand
from 0 to 30


WELL LOCATION:
sec. 32 T 7 N R 10 E
2 miles SW of Moss City
(distance) (direction) (nearest town)

WELL PURPOSE:
(home, irrigation, municipal, industrial)

WELL COMPLETION DATA:

- (1) diameter (inches) 2"
- (2) total depth (feet) 30'
- (3) static water level (feet) 4' below top of ground
- (4) casing 50% PVC 20' (material) (depth)
- (size) If telescope see back.
- (5) screen 10' (length) (depth to top)
2" (size) plastic (material)
- (6) pump 1/2 (HP) 12 (yield gpm)
electric (type power)
- (7) electric log no (yes or no)
- (organization running log)
- (8) how well bottom plugged clogged

DRILLERS REMARKS:

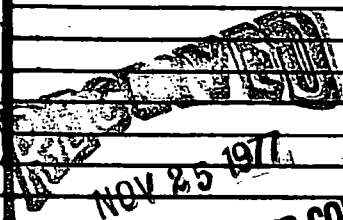

NOV 25 1977
MISS. BD. OF WATER COMMISSIONERS

If well telescopes please sketch and show depths.

GROUND LEVEL

SECTION 32

Please indicate well location X.

ADDITIONAL INFORMATION

If more than one screen, show locations of each on sketch.