

HARRISON
M 2224
6/21/77

**MISSISSIPPI
BOARD OF WATER COMMISSIONERS**
416 North State Street
Jackson, Mississippi 39201
WATER WELL DRILLERS LOG

June 21 1977 Michael Well Works Harrison
 date well completed firm name county well located

LANDOWNER: H.B. Flagg
Box 246
Apt., Mo.
 (mailing address)

description of formations encountered	from	to
<u>Sand</u>	<u>0</u>	<u>30</u>

WELL LOCATION:
 sec. 32T 7N R. 10E
1 1/2 miles S.E. of Hindsboro Bridge
 (distance) (direction) (nearest town)

WELL PURPOSE:
 (home, irrigation, municipal, industrial)

WELL COMPLETION DATA:


(1) diameter (inches) 2"
 (2) total depth (feet) 30'
 (3) static water level (feet) 4' below above
 top of ground.
 (4) casing 5.40 PVC, 20'
 (material) (depth)
 (size) If telescope see back.
 (5) screen 10', —
 (length) (depth to top)
2", plastic
 (size) (material)
 (6) pump 1/2 12
 (HP) (yield gpm)
Electric
 (type power)
 (7) electric log no
 (yes or no)
 (organization running log)
 (8) how well bottom plugged Capped

RECEIVED
 MAR - 6 1978

DRILLERS REMARKS:

If well telescopes please sketch and show depths.

GROUND LEVEL

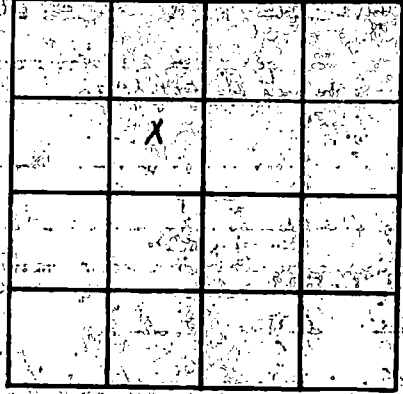

SECTION 32

Please indicate well location: X.

ADDITIONAL INFORMATION

If more than one screen, show locations of each on sketch.