

Harrison  
 M 2238  
 11/1/77

MISSISSIPPI  
 BOARD OF WATER COMMISSIONERS  
 416 North State Street  
 Jackson, Mississippi 39201

WATER WELL DRILLERS LOG

Nov 1 1977 Bay & Well Co. Harrison  
 date well completed firm name county well located

LANDOWNER: Fidelity  
Research Rd. Bilbo  
 (mailing address)

WELL LOCATION:  
 sec. 24 T. 107 N R. 10 E  
1 miles NE of Bilbo  
 (distance) (direction) (nearest town)

WELL PURPOSE: Home  
 (home, irrigation, municipal, industrial)

WELL COMPLETION DATA:

(1) diameter (inches) 4" x 2"  
 (2) total depth (feet) 397'  
 (3) static water level (feet) 28 below top of ground.  
 (4) casing RVC, 377'  
 (material) (depth)  
4x2" if telescope see back.  
 (size)  
 (5) screen 20', 897'  
 (length) (depth to top)  
100', RVC  
 (size) (material)  
 (6) pump 1 HP, 23  
 (HP) (yield gpm)  
Elect  
 (type power)  
 (7) electric log No  
 (yes or no)  
 (organization running log)  
 (8) how well bottom plugged metal sand shield

description of formations encountered	from	to
clay	0	10
sand	10	23
clay	23	34
sand	34	87
clay	37	73
sand	73	78
clay	78	85
sand	85	90
clay	90	137
sand	137	144
clay	144	190
sand	190	290
clay	210	290
sand	290	302
clay	302	361
glauk sand	361	397

RECEIVED  
 JAN 19 1978

MISS. BD. OF WATER COMM

DRILLERS REMARKS:

If well telescopes please sketch and show depths.

GROUND LEVEL


160'  
4" PVC  
Bell Reducer

2" PVC

377

397

30' PVC screen

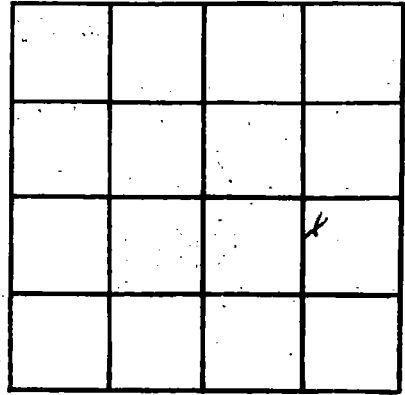

SECTION 24

Please indicate well location X.

ADDITIONAL INFORMATION

If more than one screen, show locations of each on sketch.