

Harrison  
M 2246  
2/11/78

MISSISSIPPI  
BOARD OF WATER COMMISSIONERS  
416 North State Street  
Jackson, Mississippi 39201

WATER WELL DRILLERS LOG

Feb 11 1978 Bevant Well Co. HARRISON  
date well completed firm name county well located

LANDOWNER: Doc Crowling  
Campbell Dr  
Biloxi Mo.  
(mailing address)

description of formations encountered	from	to
CLAY	0	11
CLAY	11	21
CLAY	21	57
SAND	57	60
CLAY	60	71
Good Sand	71	137

WELL LOCATION:  
sec. 14 T. 7 R. 10  
1 miles N of Biloxi  
(distance) (direction) (nearest town)

WELL PURPOSE: domestic  
(home, irrigation, municipal, industrial)

WELL COMPLETION DATA:

- (1) diameter (inches) 7"
- (2) total depth (feet) 137
- (3) static water level (feet) 24 below above top of ground.
- (4) casing PVC 129  
(material) (depth)
- If telescope see back.  
(size)
- (5) screen 90" 137  
(length) (depth to top)
- 304 PVC  
(size) (material)
- (6) pump                
(HP) (yield gpm)
- (type power)
- (7) electric log NO  
(yes or no)
- (organization running log)
- (8) how well bottom plugged MOLO  
AND JACK

DRILLERS REMARKS:       


RECEIVED

MAR 13 1978

MISS. BO. OF WATER COMMISSIONERS

If well telescopes please sketch and show depths.

GROUND LEVEL

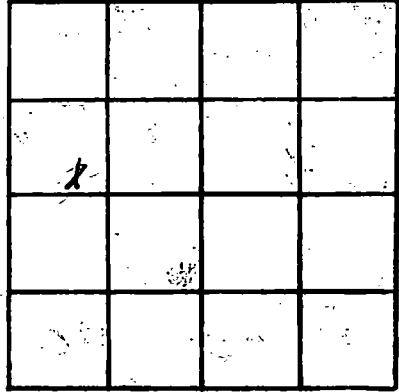

SECTION 14

Please indicate well location X.

ADDITIONAL INFORMATION

If more than one screen, show locations of each on sketch.