

HARRISON  
 M 2247  
 2/8/78

MISSISSIPPI  
 BOARD OF WATER COMMISSIONERS  
 416 North State Street  
 Jackson, Mississippi 39201

1600' 40"  
 340-24

WATER WELL DRILLERS LOG

2/8/78 19 Coastal Drilling Harrison  
 date well completed firm name county well located  
Bilal Min

LANDOWNER: Joe Jacob  
Blendale water system  
Bilal Rt 1, Min  
 (mailing address)

description of formations encountered	from	to
	Top Soil	1
Red Sand + Clay	3	9.5
Soft Blue Clay	35	230
fine water sand	230	240
Soft Blue Clay	240	320
Hard Blue Clay	320	450
fine water sand	450	470
Coarse water sand	470	500

WELL LOCATION:  
 sec. 4 T 2 N R 10 E  
Wadsworth  
 (distance) (direction) (nearest town)

WELL PURPOSE: Water System  
 (home, irrigation, municipal, industrial)

- WELL COMPLETION DATA:
- (1) diameter (inches) 4 1/2"
  - (2) total depth (feet) 500'
  - (3) static water level (feet) 30 below above top of ground.
  - (4) casing pvc 490'  
 (material) (depth)  
4 1/2" If telescope see back.  
 (size)
  - (5) screen 15' 485'  
 (length) (depth to top)  
2" pvc  
 (size) (material)
  - (6) pump 2 HP 35  
 (HP) (yield gpm)  
Elec  
 (type power)
  - (7) electric log no  
 (yes or no)

(organization running log)

(8) how well bottom plugged  
Backwash valve

DRILLERS REMARKS:

**RECEIVED**  
 APR 17 1978

MISS. BD. OF WATER COMM

If well telescopes please sketch and show depths.


GROUND LEVEL

160' 4" PDC Casing

325' 2" PDC Casing

15ft 2" PDC screen

2" backwash valve

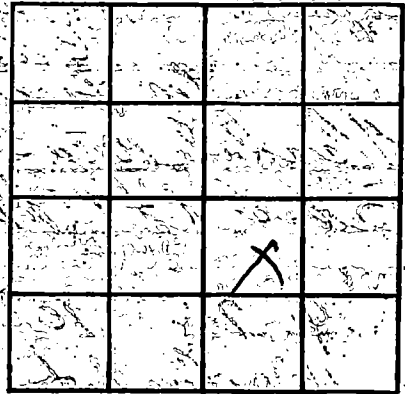

SECTION \_\_\_\_\_

Please indicate well location X.

ADDITIONAL INFORMATION

If more than one screen, show locations of each on sketch.