

HARRISON
 M 2249
 3-8-78

MISSISSIPPI
 BOARD OF WATER COMMISSIONERS
 416 North State Street
 Jackson, Mississippi 39201

WATER WELL DRILLERS LOG

March 8 1978 *Harrison Well Drilling Harrison*
 date well completed firm name county well located

LANDOWNER: *D.B. Ward*
2317-19th Ave
Shuford Mo.
 (mailing address)

description of formations encountered	from	to
<i>sand</i>	<i>0</i>	<i>35</i>

WELL LOCATION:
 sec *3* T *7* N *(S)* R *10* E *(W) ?*
in town miles _____ of _____
 (distance) (direction) (nearest town)

WELL PURPOSE *drain well*
 (home, irrigation, municipal, industrial)

WELL COMPLETION DATA:
 (1) diameter (inches) *2"*
 (2) total depth (feet) *35'*
 (3) static water level (feet) _____ below/above top of ground.
 (4) casing *PVC* *25'*
 (material) (depth)
 _____ If telescope see back.
 (size)
 (5) screen *10'* *25'*
 (length) (depth to top)
2' *PVC sch. 40*
 (size) (material)
 (6) pump *1/2* *11*
 (HP) (yield gpm)
electric
 (type power)
 (7) electric log *NO*
 (yes or no)

 (organization running log)

(8) how well bottom plugged *cap*

DRILLERS REMARKS:


RECEIVED

AUG 11 1978

MISS. BD. OF WATER COMM.

If well telescopes please sketch and show depths.

GROUND LEVEL

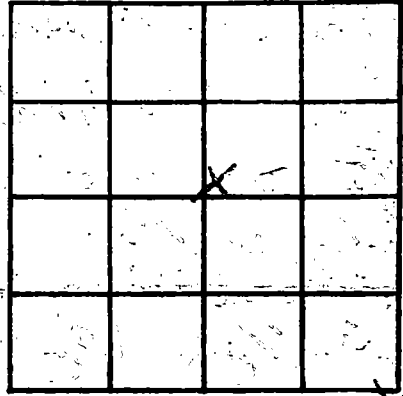

SECTION 3

Please indicate well location X.

ADDITIONAL INFORMATION

If more than one screen, show locations of each on sketch.