

HARRISON
 M 2252
 5/3/78

MISSISSIPPI
 BOARD OF WATER COMMISSIONERS
 416 North State Street
 Jackson, Mississippi 39201

WATER WELL DRILLERS LOG

5/3/78 19 Coastal Drilling Harrison
 date well completed firm name county well located
R.T. Bilski Miss

LANDOWNER:	description of formations encountered	from	to
<u>None planned</u>	<u>Top Soil</u>	<u>1</u>	<u>3</u>
<u>Bennett Sub</u>	<u>Red Clay</u>	<u>3</u>	<u>15</u>
<u>Bilski, Miss</u> (mailing address)	<u>White Sand</u>	<u>15</u>	<u>40</u>
	<u>Soft Blue Clay</u>	<u>40</u>	<u>90</u>
	<u>Hard Blue Clay</u>	<u>90</u>	<u>290</u>
	<u>fine white sand</u>	<u>290</u>	<u>310</u>
	<u>Coarse white sand</u>	<u>310</u>	<u>335</u>

WELL LOCATION:
 sec. 5 T. 7 N. R. 10 E
S W
Coahuilla
 (distance) (direction) (nearest town)

WELL PURPOSE: Home
 (home, irrigation, municipal, industrial)

- WELL COMPLETION DATA:
- (1) diameter (inches) 2"
 - (2) total depth (feet) 335'
 - (3) static water level (feet) 50 below top of ground.
 - (4) casing PVC 325'
(material) (depth)
 - (size) If telescope see back.
 - (5) screen 10' 325'
(length) (depth to top)
 - 2" PVC
(size) (material)
 - (6) pump One 12
(HP) (yield gpm)
 - Elc
(type power)
 - (7) electric log no
(yes or no)
 - (organization running log)

(8) has well bottom plugged
2 backwash valves


DRILLERS REMARKS:

RECEIVED

JUL 18 1978

If well telescopes please sketch and show depths.

GROUND LEVEL

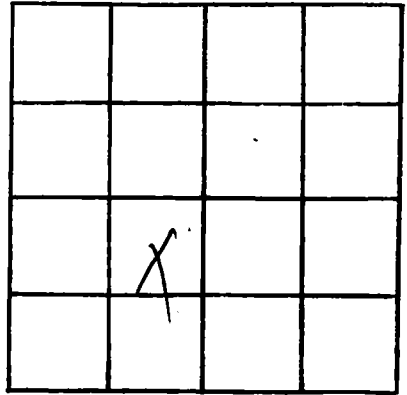

SECTION _____

Please indicate well location X.

ADDITIONAL INFORMATION

If more than one screen, show locations of each on sketch.