

HARRISON
M2257
6-17-78

MISSISSIPPI
BOARD OF WATER COMMISSIONERS
416 North State Street
Jackson, Mississippi 39201

WATER WELL DRILLERS LOG

June 17 1978 Bryant Well Co. Harrison
date well completed firm name county well located

LANDOWNER: <u>Berkson</u>	description of formations encountered	from	to
<u>Smith Road</u> <u>Biloxi Miss</u> (mailing address)			
WELL LOCATION: sec. <u>6</u> T. <u>76</u> N. R. <u>9</u> E <u>1 1/2</u> miles <u>NW</u> of <u>North</u> (distance) (direction) (nearest town)	<u>clay</u>	<u>0</u>	<u>23</u>
	<u>sand</u>	<u>23</u>	<u>44</u>
	<u>clay</u>	<u>44</u>	<u>110</u>
	<u>fine sand</u>	<u>110</u>	<u>121</u>
	<u>clay</u>	<u>121</u>	<u>181</u>
	<u>sand</u>	<u>181</u>	<u>194</u>
	<u>clay</u>	<u>194</u>	<u>242</u>
WELL PURPOSE: <u>Home</u> (home, irrigation, municipal, industrial)	<u>fine sand</u>	<u>242</u>	<u>288</u>
	<u>clay</u>	<u>248</u>	<u>321</u>
	<u>good sand</u>	<u>321</u>	<u>343</u>

WELL COMPLETION DATA:

(1) diameter (inches) 2"

(2) total depth (feet) 343

(3) static water level (feet) 47 ~~49~~ ^{below} ~~above~~ top of ground.

(4) casing PVC, 333
(material) (depth)

10' If telescope see back.
(size)

(5) screen 108, 343
(length) (depth to top)

108', PVC
(size) (material)

(6) pump 1 11
(HP) (yield gpm)

electric
(type power)

(7) electric log _____
(yes or no)

(organization running log)


(8) how well bottom plugged metal
and sand

RECEIVED
AUG 15 1978
MISS. BD. OF WATER COMM.

DRILLERS REMARKS:

If well telescopes please sketch and show depths.

GROUND LEVEL

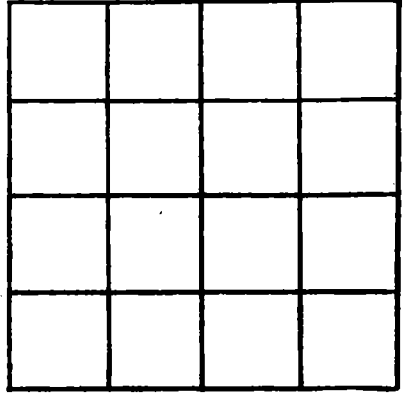

SECTION 6

Please indicate well location X.

ADDITIONAL INFORMATION

If more than one screen, show locations of each on sketch.