

HARRISON
M 2262
8-11-78

**MISSISSIPPI  
BOARD OF WATER COMMISSIONERS**  
416 North State Street  
Jackson, Mississippi 39201

**WATER WELL DRILLERS LOG**

8/11 1978 *Edwards Well Drilling Harrison*  
 date well completed      firm name      county well located

LANDOWNER: *John W. Lyle*

(mailing address)

WELL LOCATION:  
 sec. 4 T. 70 N. R. 10 E.  
5 miles (distance) SE (direction) of Oslo (nearest town)

description of formations encountered	from	to
Clay	0	12
Sand	12	35
Red & White Clay	35	75
Blue Clay	75	280
fine sand	280	330
coarse sand	330	340

WELL PURPOSE: home  
 (home, irrigation, municipal, industrial)

WELL COMPLETION DATA:

(1) diameter (inches) 2"

(2) total depth (feet) 340

(3) static water level (feet) 30' <sup>below</sup> above top of ground.

(4) casing PVC (material) 330 (depth)

     If telescope see back.  
 (size)

(5) screen 10' (length) 330 (depth to top)

2" (size) PVC (material)

(6) pump 1 (HP) 12 (yield gpm)

electric (type power)

(7) electric log      (yes or no)

(organization running log)

(8) how well bottom plugged hard

Shark


DRILLERS REMARKS:

**RECEIVED**

JAN 10 1978

If well telescopes please sketch and show depths.

GROUND LEVEL

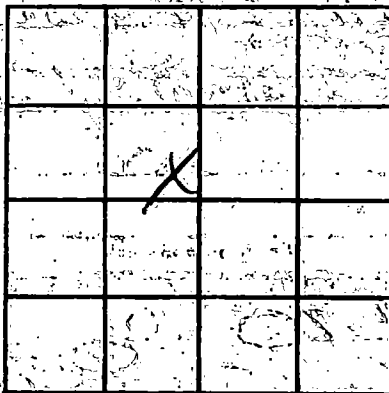

SECTION 4

Please indicate well location X.

ADDITIONAL INFORMATION

If more than one screen, show locations of each on sketch.