

HARRISON  
 M 2266  
 11-03-78

MISSISSIPPI  
 BOARD OF WATER COMMISSIONERS  
 416 North State Street  
 Jackson, Mississippi 39201

WATER WELL DRILLERS LOG

11/3/78 19 Coated Drilling Harrison  
 date well completed firm name county well located  
Bilal Min

LANDOWNER John Spence  
PT 1/609 B  
Bilal Min  
 (mailing address)

description of formations encountered	from	to
top soil	1	3
Red Clay	3	18
Coarse white sand	18	40
Soft Blue Clay	40	180
fine water sand	180	220
Soft Blue Clay	220	315
fine water sand	315	330
Hard Blue Clay	330	480
fine water sand	480	510
Coarse white sand	510	550

WELL LOCATION:  
 sec 3 T 7 N R 10 E  
1 1/2 miles SE of Coalville  
 (distance) (direction) (nearest town)

WELL PURPOSE: home  
 (home, irrigation, municipal, industrial)

- WELL COMPLETION DATA:
- (1) diameter (inches) 4 1/2"
  - (2) total depth (feet) 550'
  - (3) static water level (feet) 60 below top of ground
  - (4) casing PVC 535'  
 (material) (depth)  
4 1/2" if telescope see back.  
 (size)
  - (5) screen 15' 535'  
 (length) (depth to top)  
2" (size) PVC (material)
  - (6) pump One 20  
 (HP) (yield gpm)  
Electric (type power)
  - (7) electric log No  
 (yes or no)
- (organization running log)

(8) how well bottom plugged  
2" backwash valve

DRILLERS REMARKS:

Miss. Board of Water Comm.


APR 23 1979

RECEIVED

If well telescopes please sketch and show depths.

GROUND LEVEL

200' 4" PVC  
Casing

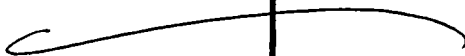


335' 2" PVC  
Casing

15 ft 2" PVC Screen

2" Check Valve Valve

If more than one screen,  
show locations of each on sketch.

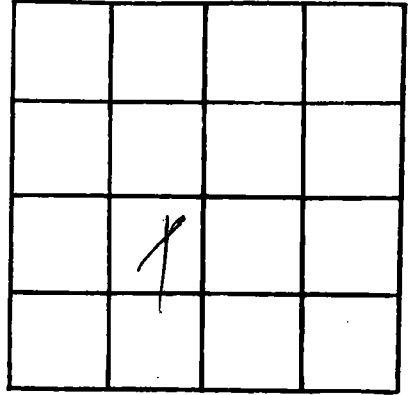

SECTION \_\_\_\_\_

Please indicate well location X.

ADDITIONAL INFORMATION

Lined area for additional information.