

HARRISON

M 2269

11-27-78

MISSISSIPPI BOARD OF WATER COMMISSIONERS
416 North State Street
Jackson, Mississippi 39201

WATER WELL DRILLERS LOG

11/27/78 19 Coastal Well Drilling Firm name Harrison county well located
date well completed Biloxi Miss

LANDOWNER: Beef Hurley

Cedar Lake

Biloxi Miss
(mailing address)

description of formations encountered	from	to
<u>top soil</u>	<u>1</u>	<u>3</u>
<u>Soft Red Clay</u>	<u>3</u>	<u>18</u>
<u>Silver Sand</u>	<u>18</u>	<u>24</u>
<u>Coarse white Sand</u>	<u>24</u>	<u>40</u>

WELL LOCATION:

sec. 6 T 2 N R 9 E
S W
Cedar Lake
(distance) (direction) (nearest town)

WELL PURPOSE: irrigation
(home, irrigation, municipal, industrial)
Water heat pump

WELL COMPLETION DATA:

- (1) diameter (inches) 2"
- (2) total depth (feet) 40'
- (3) static water level (feet) 10' below above top of ground.
- (4) casing PVC 30'
(material) (depth)
- (size) if telescope see back.
- (5) screen 10' 30'
(length) (depth to top)
- 2" PVC
(size) (material)
- (6) pump one 15
(HP) (yield gpm)
- 3/4" 240
(type power)
- (7) electric log no
(yes or no)

(organization running log)

(8) flow well bottom plugged
2 1/2" submersible pump

DRILLERS REMARKS: 19-B


Miss. Board of Water Comm.

APR 23 1979

RECEIVED

If well telescopes please sketch and show depths.

GROUND LEVEL

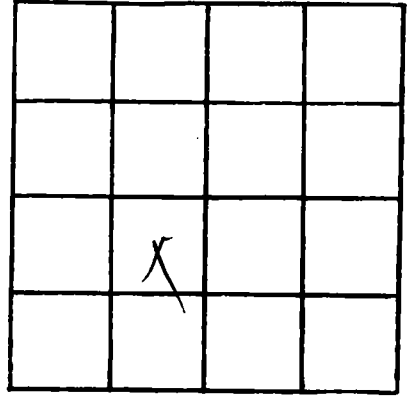

SECTION _____

Please indicate well location X.

ADDITIONAL INFORMATION

If more than one screen,
show locations of each on sketch.