

HARRISON

M 2271

12-04-78

MISSISSIPPI BOARD OF WATER COMMISSIONERS  
416 North State Street  
Jackson, Mississippi 39201

WATER WELL DRILLERS LOG

12/4/78 19 Coastal Drilling Harrison  
date well completed firm name county well located  
Biloxi Min

LANDOWNER: John Brunley  
Rt 1 Woolmarket  
Biloxi Min  
(mailing address)

description of formations encountered	from	to
	top soil	1
Red Clay	3	15
Sandy Sand	15	40
Coarse white sand	40	60
Soft Blue Clay	60	260
Hard Blue Clay	260	460
fine white sand	460	480
Coarse white sand	480	570

WELL LOCATION:  
sec. 2 T 2 N R 10 E  
2 1/2 miles West Cedar Lake  
(distance) (direction) (nearest town)

WELL PURPOSE: home  
(home, irrigation, municipal, industrial)

- WELL COMPLETION DATA:
- (1) diameter (inches) 2"
  - (2) total depth (feet) 510'
  - (3) static water level (feet) 25' below top of ground
  - (4) casing PVC, 500' (material) (depth)  
(size) If telescope see back.
  - (5) screen 10' PVC (length) (depth to top)  
2" PVC (size) (material)
  - (6) pump One 15 (HP) (yield gpm)  
ELe (type power)
  - (7) electric log (yes or no)
- (organization running log)

(8) how well bottom plugged  
2 1/2 miles West Cedar Lake

DRILLERS REMARKS:


Miss. Board of Water Comm.

APR 29 1979

RECEIVED

If well telescopes please sketch and show depths.

GROUND LEVEL

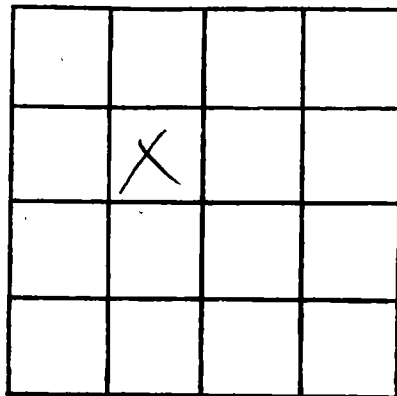

SECTION \_\_\_\_\_

Please indicate well location X.

ADDITIONAL INFORMATION

If more than one screen,  
show locations of each on sketch.