

HARRISON  
 M 2272  
 12-06-78

MISSISSIPPI  
 BOARD OF WATER COMMISSIONERS  
 416 North State Street  
 Jackson, Mississippi 39201

WATER WELL DRILLERS LOG

12/16/78 19 Coastal Drilling Harrison  
 date well completed firm name county well located  
 Bilal's Sons

LANDOWNER: Clarence Jordan Jr.  
 Subskull Rd  
 Bilal's Sons  
 (mailing address)

description of formations encountered	from	to
top soil	1	3
Red Clay	3	15
Soft Blue Clay	15	35
Coarse white sand	35	60
Soft Blue Clay	60	230
hard Blue Clay	230	270
fine water sand	270	280
Coarse water sand	280	300

WELL LOCATION:  
 sec. 4 T. 7 N R. 9 E  
 S W  
 2 1/2 miles North of Oshtemo  
 (distance) (direction) (nearest town)

WELL PURPOSE: home  
 (home, irrigation, municipal, industrial)

WELL COMPLETION DATA:  
 (1) diameter (inches) 2"  
 (2) total depth (feet) 300'  
 (3) static water level (feet) 40' below top of ground.  
 (4) casing PVC 290'  
 (material) (depth)  
 If telescope see back.  
 (size)  
 (5) screen 10' 290'  
 (length) (depth to top)  
 2" PVC  
 (size) (material)  
 (6) pump one 1/2"  
 (HP) (yield gpm)  
 3/4"  
 (type power)  
 (7) electric log no  
 (yes or no)  
 (organization running log)

(8) how well bottom plugged  
 24 inch submersible  
 DRILLERS REMARKS:

Miss. Board of Water Comm.


APR 23 1979

RECEIVED


If well telescopes please sketch and show depths.

GROUND LEVEL

Bayton, Haw

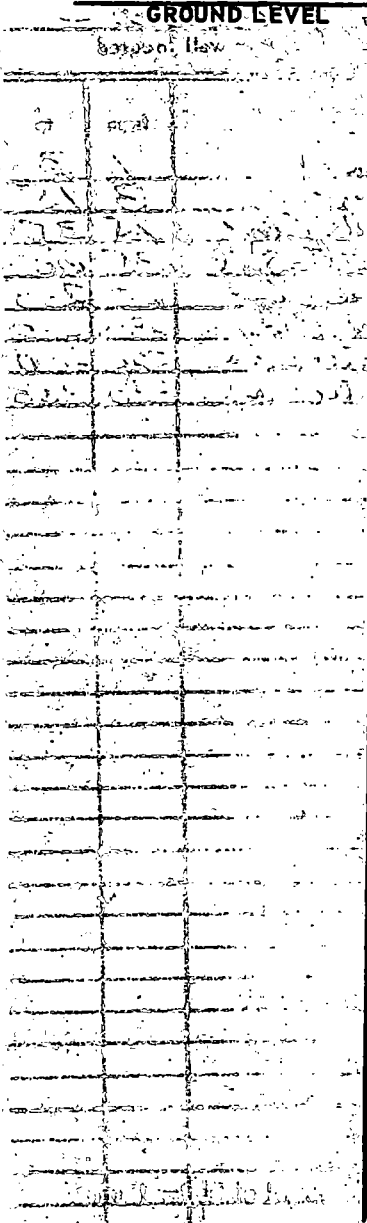

If more than one screen, show locations of each on sketch.

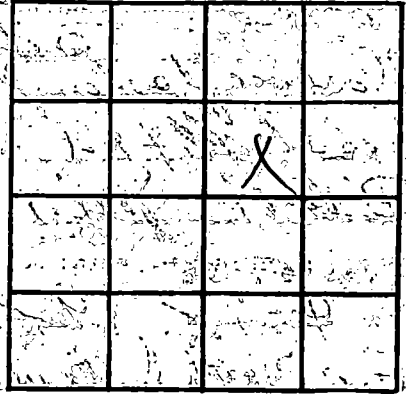

SECTION \_\_\_\_\_

Please indicate well location X.

ADDITIONAL INFORMATION

Multiple horizontal lines for providing additional information.