

HARRISON
M 2273
12-23-78

MISSISSIPPI
BOARD OF WATER COMMISSIONERS
416 North State Street
Jackson, Mississippi 39201

WATER WELL DRILLERS LOG

12-23-78 19 Switzer well Co. Harrison
date well completed firm name county well located

LANDOWNER: <u>JULIAN FAYARD</u>	description of formations encountered	from	to
<u>Boyette Road</u>	<u>Clay-w/lt Sand strks</u>	<u>0</u>	<u>82</u>
<u>Walmarket, Miss.</u>	<u>CLAY</u>	<u>82</u>	<u>158</u>
(mailing address)	<u>SAND</u>	<u>158</u>	<u>183</u>
	<u>CLAY</u>	<u>183</u>	<u>230</u>
	<u>SAND FINE</u>	<u>230</u>	<u>255</u>
	<u>CLAY</u>	<u>255</u>	<u>276</u>
	<u>SAND FINE</u>	<u>276</u>	<u>284</u>
	<u>SAND med</u>	<u>284</u>	<u>304</u>
	<u>SAND + GRAVEL</u>	<u>304</u>	<u>331</u>

WELL LOCATION:
sec. 4 T. 7 N. R. 10 E.
8 miles NW of Dyersville
(distance) (direction) (nearest town)

WELL PURPOSE: Home
(home, irrigation, municipal, industrial)

WELL COMPLETION DATA:

(1) diameter (inches) 4x2

(2) total depth (feet) 331'

(3) static water level (feet) 41 below above top of ground.

(4) casing PVC, 316'
(material), (depth)
4x2 (size) if telescope see back.

(5) screen 15', 316'
(length), (depth to top)
2", PVC
(size), (material)


(6) pump 1 19
(HP), (yield gpm)
AC
(type power)

(7) electric log NO
(yes or no)

(organization running log)

(8) how well bottom plugged METAL
BRICK WASH

DRILLERS REMARKS:

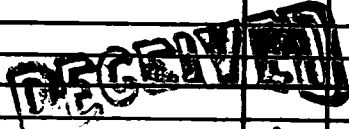

JAN 11 1978

WATER COMM

If well telescopes please sketch and show depths.

GROUND LEVEL

200'
4'

116' 2"

15'
SCREEN

	X		

SECTION 4

Please indicate well location X.

ADDITIONAL INFORMATION

If more than one screen, show locations of each on sketch.