

HARRISON  
M 2274  
1-5-79

MISSISSIPPI  
BOARD OF WATER COMMISSIONERS  
416 North State Street  
Jackson, Mississippi 39201

WATER WELL DRILLERS LOG

COASTAL DRILLING & SERVICE CO

Harrison  
county well located

1/15/79  
date well completed

ROUTE # BOX 618

LANDOWNER: C. Cooper BLOX

MISS. 39537  
description of formations encountered

from to

Rt 1 Box 714  
Blox 1, Miss  
(mailing address)

Top Soil	1	3
Red Clay	3	19
Super Sand	19	60
5 ft Blue Clay	60	270
Soil Under Sand	270	300
Top	300	310
hard Blue Clay	310	440
fine water sand	440	450
Coarse water sand	450	485

WELL LOCATION:

sec. 10 T. 7 N R. 10 E  
S W  
Johntreehuffa River  
(distance) (direction) (nearest town)

WELL PURPOSE: home  
(home, irrigation, municipal, industrial)

WELL COMPLETION DATA:

- (1) diameter (inches) 2"
- (2) total depth (feet) 485'
- (3) static water level (feet) 25' below top of ground.
- (4) casing PVC 475' (depth)
- (size) If telescope see back.
- (5) screen 10' 475' (length) (depth to top)
- 2" PVC (size) (material)
- (6) pump one 15 (HP) (yield gpm)
- 3hp (type power)
- (7) electric log no (yes or no)

(organization running log)

(9) how well bottom plugged  
2" PVC with valve

DRILLERS REMARKS: 19-B


Miss. Board of Water Comm.

MAY 16 1979

RECEIVED

If well telescopes please sketch and show depths.

GROUND LEVEL

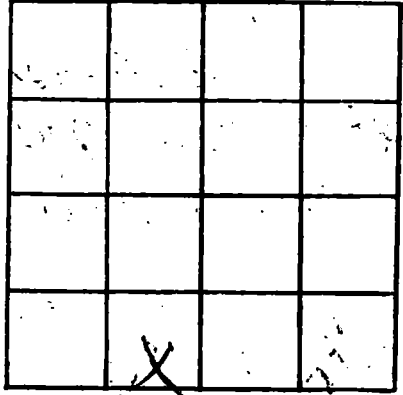

SECTION \_\_\_\_\_

Please indicate well location X.

ADDITIONAL INFORMATION

If more than one screen, show locations of each on sketch.