

HARRISON
M 2281
04-17-79

**MISSISSIPPI
BOARD OF WATER COMMISSIONERS**
416 North State Street
Jackson, Mississippi 39201
WATER WELL DRILLERS LOG

4-17-79 19 Switzer Well Co. Harrison
 date well completed firm name county well located

LANDOWNER: <u>Jiggs Hudson</u>	description of formations encountered	from	to
<u>Rt. 1</u>		<u>SAND & GRAVEL</u>	<u>0</u>
<u>Guleport Miss.</u> (mailing address)	<u>Mixed Clay</u>	<u>60</u>	<u>100</u>
WELL LOCATION:	<u>Clay</u>	<u>100</u>	<u>226</u>
sec. <u>8</u> T. <u>7</u> N. R. <u>10</u> E	<u>SAND</u>	<u>226</u>	<u>234</u>
<u>5</u> miles <u>N</u> of <u>Hanksboro</u>	<u>Clay & Shale</u>	<u>234</u>	<u>281</u>
(distance) (direction) (nearest town)	<u>SAND & small gravel</u>	<u>281</u>	<u>302</u>
WELL PURPOSE: <u>Home</u> (home, irrigation, municipal, industrial)			
WELL COMPLETION DATA:			
(1) diameter (inches) <u>2"</u>			
(2) total depth (feet) <u>302</u>			
(3) static water level (feet) <u>8</u> <u>below</u> above top of ground.			
(4) casing <u>galv</u> <u>292</u> (material) (depth)			
<u>2"</u> (size) If telescope see back.			
(5) screen <u>10</u> <u>292</u> (length) (depth to top)			
<u>2"</u> <u>Stainless Steel</u> (size) (material)			
(6) pump <u>1</u> <u>18</u> (HP) (yield gpm)			
<u>AC</u> (type power)			
(7) electric log <u>NO</u> (yes or no)			
(organization running log)			
(8) how well bottom plugged <u>Metal</u> <u>BACKWASH</u>			
DRILLERS REMARKS:			


Miss. Board of Water Comm

APR 20 1979

RECEIVED

If well telescopes please sketch and show depths.

GROUND LEVEL

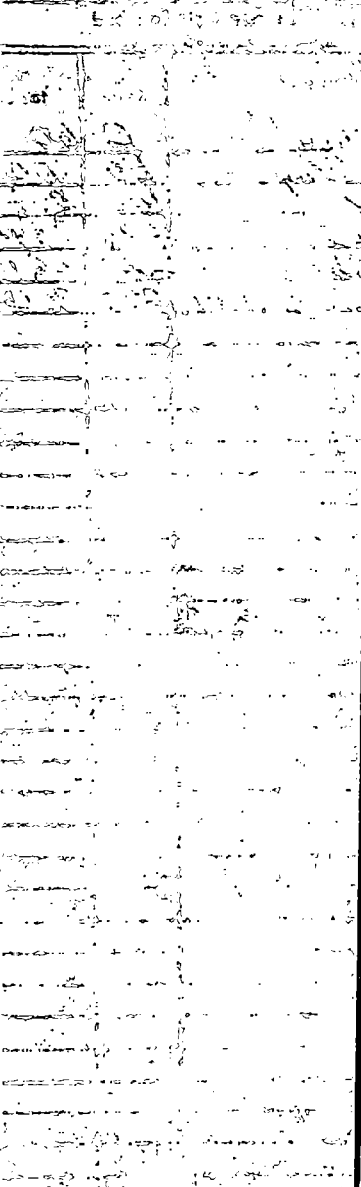

X			

SECTION 8

Please indicate well location X.

ADDITIONAL INFORMATION

A series of horizontal lines for providing additional information, with some faint handwritten notes visible.

If more than one screen, show locations of each on sketch.