

HARRISON
M 2285
5-5-79

MISSISSIPPI
BOARD OF WATER COMMISSIONERS
416 North State Street
Jackson, Mississippi 39201

WATER WELL DRILLERS LOG

May 5 1979 Duncan Well Drilling Harrison
date well completed firm name county well located

LANDOWNER: Melvin Bell
133 Seal Ave.
Biloxi, Ms. 39530
(mailing address)

description of formations encountered	from	to
	<u>sand</u>	<u>0</u>

WELL LOCATION:
sec. 26 T 7 N R 10 E
In Down miles of Biloxi
(distance) (direction) (nearest town)

WELL PURPOSE: irrigation
(home, irrigation, municipal, industrial)

- WELL COMPLETION DATA:
- (1) diameter (inches) 2"
 - (2) total depth (feet) 30'
 - (3) static water level (feet) 5' below above
top of ground.
 - (4) casing PVC 20'
(material) (depth)
 - (size) If telescope see back.
 - (5) screen 10' 20'
(length) (depth to top)
 - 2 PVC
(size) (material)
 - (6) pump _____ (HP) _____ (yield gpm)
 - (type power)
 - (7) electric log _____ (yes or no)
 - (organization running log)
 - (8) how well bottom plugged hard

Miss. Board of Water Comm.

JUN - 5 1979


RECEIVED

DRILLERS REMARKS:
Installed his own pump

If well telescopes please sketch and show depths.

GROUND LEVEL

Level of flow

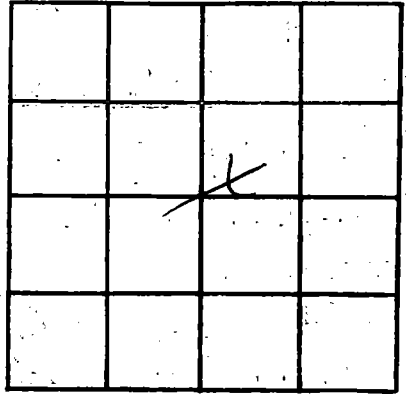

SECTION 26

Please indicate well location X.

ADDITIONAL INFORMATION

If more than one screen, show locations of each on sketch.