

MISSISSIPPI DEPARTMENT OF NATURAL RESOURCES

Bureau of Land and Water Resources

Southport Mall

P.O. Box 10631

Jackson, Mississippi 39209

WATER WELL DRILLERS LOG

COASTAL DRILLING & SERVICE CO.

HARRISON
M 2292
6-30-79

6/30/79
date well completed

ROUTE 1 BOX 618

Harrison
county well located

LANDOWNER: Charles Bilal BILAL MISS

description of formations encountered	from	to
<u>Top Soil</u>	<u>1</u>	<u>3</u>
<u>Soft Blue Clay</u>	<u>3</u>	<u>30</u>
<u>Soft Sand</u>	<u>30</u>	<u>65</u>
<u>Soft Blue Clay</u>	<u>65</u>	<u>210</u>
<u>Free Water Sand</u>	<u>210</u>	<u>225</u>
<u>Hard Blue Clay</u>	<u>225</u>	<u>440</u>
<u>Free Water Sand</u>	<u>440</u>	<u>470</u>
<u>Coarse Water Sand</u>	<u>470</u>	<u>506</u>

Summit Zone
Bilal's Miss
(mailing address)

WELL LOCATION:

sec. 18 T. 1 N. R. 9 E.
S. W. N. E.
(None) mile (West) of (Lake) town

WELL PURPOSE: home
(home, irrigation, municipal, industrial)

WELL COMPLETION DATA:

- (1) diameter (inches) 2"
- (2) total depth (feet) 506
- (3) static water level (feet) 35' below above top of ground.
- (4) casing PVC 496'
(material) (depth)
- (size) If telescope see back.
- (5) screen 10' 496'
(length) (depth to top)
- 2" PVC
(size) (material)
- (6) pump One 10
(HP) (yield gpm)
- 5hp
(type power)
- (7) electric log no
(yes or no)

(organization running log)

(8) how well bottom plugged
2' back with valve

DRILLERS REMARKS: 19-B


DEPT. OF NATURAL RESOURCES
BUREAU OF LAND & WATER RESOURCES

OCT 31 1980

RECEIVED

If well telescopes please sketch and show depths.

GROUND LEVEL

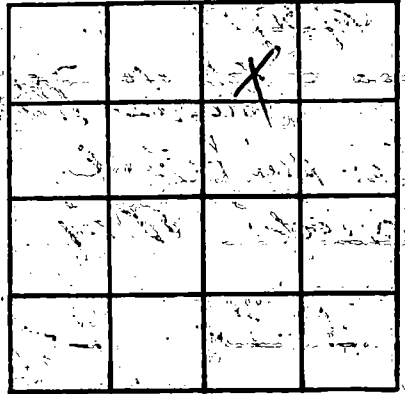

SECTION _____

Please indicate well location X.

ADDITIONAL INFORMATION

Multiple horizontal lines for additional information.

If more than one screen, show locations of each on sketch.

DEPARTMENT OF THE ARMY
ENGINEER REGIMENT
FORT MONMOUTH, N.J.