

MISSISSIPPI DEPARTMENT OF NATURAL RESOURCES

Bureau of Land and Water Resources

Southport Mall

P.O. Box 10631

Jackson, Mississippi 39209

WATER WELL DRILLERS LOG

COASTAL DRILLING & SERVICE CO.

ROUTE 1 BOX 648

county well located

HARRISON

M 2293

6-30-79

date well completed

LANDOWNER

BILOXI MISS

Description of formations encountered

from to

Subst Zone

Bilali Min

(mailing address)

WELL LOCATION:

sec. B T. 7 N. R. 9 E.

(distance) miles (direction) (nearest town)

WELL PURPOSE:

(home, irrigation, municipal, industrial)

WELL COMPLETION DATA:

- (1) diameter (inches) 2"
- (2) total depth (feet) 506
- (3) static water level (feet) 90 below top of ground

(4) casing PVC 496' (material) (depth)

(size) if telescope see back.

(5) screen 10' 496' (length) (depth to top)

2" PVC (size) (material)

(6) pump one 12 (HP) (yield gpm)

Ele (type power)

(7) electric log no (yes or no)

(organization running log)

(8) how well bottom plugged

DRILLERS REMARKS: 19-B

Description of formations encountered	from	to
Top Soil	1	3
Red Clay	3	15
Soft Blue Clay	20	30
Sandy Sand	30	70
Soft Blue Clay	70	210
Hard Blue Clay	210	430
Thin Water Sand	430	470
Coarse Water Sand	470	506


DEPT. OF NATURAL RESOURCES
BUREAU OF LAND & WATER RESOURCES

OCT 31 1980

RECEIVED

If well telescopes please sketch and show depths.

GROUND LEVEL

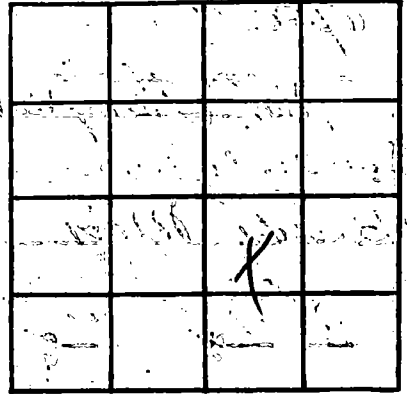

SECTION _____

Please indicate well location X.

ADDITIONAL INFORMATION

RECEIVED

If more than one screen, show locations of each on sketch.