

MISSISSIPPI DEPARTMENT OF NATURAL RESOURCES

Bureau of Land and Water Resources

Southport Mall

P.O. Box 10631

Jackson, Mississippi 39209

WATER WELL DRILLERS LOG

COASTAL DRILLING & SERVICE CO.

HARRISON
M 2295
7-10-79

7/10/79 date well completed ROUTE 1 BOX 618 firm name
HARRISON county well located
BLOXIE, MISS. 39532

LANDOWNER: Edward Brown
Pt 1 Bcf 706 B
Bloxie, Miss
(mailing address)

WELL LOCATION:
sec. 4 T. 7 N R. 10 E
Woolmarket
(distance) (direction) (nearest town)

WELL PURPOSE: Home
(home, irrigation, municipal, industrial)

WELL COMPLETION DATA:
(1) diameter (inches) 2"
(2) total depth (feet) 330'
(3) static water level (feet) 40' below top of ground.
(4) casing PVC 320' (depth)
(size) if telescope see back.
(5) screen 10' 320' (length) (depth to top)
2" PVC (size) (material)
(6) pump One 13 (HP) (yield gpm)
EVE (type power)
(7) electric log Yes (yes or no)
(organization running log)

description of formations encountered	from	to
Top Soil	1	3
Red Clay	3	15
Supple Sand	15	30
White Sand (fine)	30	65
Soft Blue Clay	65	240
Hard Blue Clay	240	290
fine white Sand	290	310
Soft White Sand	310	330

(8) how well bottom plugged
2" backwash valve
DRILLERS REMARKS: 17-15


DEPT. OF NATURAL RESOURCES
BUREAU OF LAND & WATER RESOURCES

NOV - 3 1980

RECEIVED

If well telescopes please sketch and show depths.

GROUND LEVEL

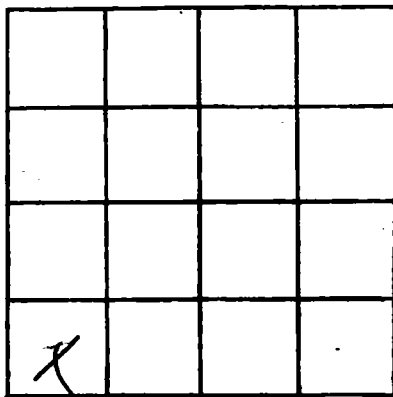

SECTION _____

Please indicate well location X.

ADDITIONAL INFORMATION

If more than one screen, show locations of each on sketch.