

MISSISSIPPI DEPARTMENT OF NATURAL RESOURCES

Bureau of Land and Water Resources

Southport Mall

P.O. Box 10631

Jackson, Mississippi 39209

WATER WELL DRILLERS LOG

COASTAL DRILLING & SERVICE CO.

HARRISON
M 2297
8-14-79

8/14/79
date well completed

ROUTE 1 BOX 628

Harrison
County well located

LANDOWNER: James Turner

description of formations encountered

from to

Rt 2 Box 435

top soil 1 3

Blushy Man Adolph
(mailing address)

Soft blue clay 3 35

WELL LOCATION:

sec. L 7 N R. 10 E
S W

Coarse white sand 35 60

Cedar Lake
(distance) (direction) (nearest town)

Soft blue clay 60 210

WELL PURPOSE: None
(home, irrigation, municipal, industrial)

Coarse white sand 210 240

WELL COMPLETION DATA:

(1) diameter (inches) 4 1/2"

Hard blue clay 240 420

(2) total depth (feet) 490'

(3) static water level (feet) 40 below above top of ground

Coarse white sand 420 460

(4) casing PVC 475'
(material) (depth)

4 1/2"
(size) If telescope see back.

Coarse white sand 460 490

(5) screen 15' 475'
(length) (depth to top)

2" PVC
(size) (material)

(6) pump One 20
(HP) (yield gpm)

Ele
(type power)

(7) electric log no
(yes or no)

DEPT. OF NATURAL RESOURCES
BUREAU OF LAND & WATER RESOURCES

OCT 3 - 1980

RECEIVED


(8) has well bottom plugged
2nd water valve

DRILLERS REMARKS:

If well telescopes please sketch and show depths.

GROUND LEVEL

160' 4" PVC Casing

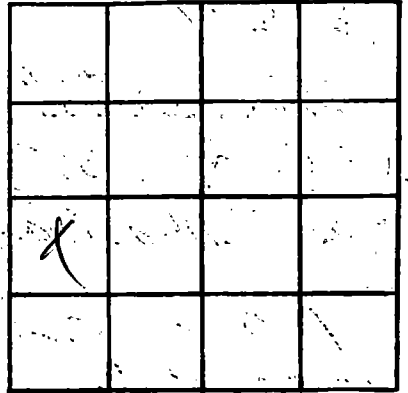

SECTION _____

Please indicate well location X.

ADDITIONAL INFORMATION

315' 2" PVC Casing

15' 2" PVC Screen

2" Buck Wash Valve
19-B

If more than one screen,
show locations of each on sketch.