

MISSISSIPPI DEPARTMENT OF NATURAL RESOURCES

Bureau of Land and Water Resources

Southport Mall

P.O. Box 10631

Jackson, Mississippi 39209

WATER WELL DRILLERS LOG

COASTAL DRILLING & SERVICE CO.

HARRISON
M 2298
10/30/79

10/30/79
date well completed

ROUTE 1 BOX 618
firm name

Harrison
county well located

BILOXI, MISS. 39537

LANDOWNER: P. McLeod
170 Central Ave
Biloxi, Miss
(mailing address)

description of formations encountered	from	to
Top Soil	1	3
Soft Blue Clay	3	20
Coarse unsorted sand	20	70
Soft Blue Clay	70	210
fine water sand	210	235
Soft Blue Clay	235	310
hard blue clay	310	390
fine water sand	390	400
good water sand	400	425

WELL LOCATION:
S 19 T 7 N 9 R 9 E W
O'Learyville
(distance) (direction) of (nearest town)

WELL PURPOSE: home
(home, irrigation, municipal, industrial)

- WELL COMPLETION DATA:
- (1) diameter (inches) 2"
 - (2) total depth (feet) 425'
 - (3) static water level (feet) 40' below above top of ground.
 - (4) casing PVC, 415'
(material) (depth)
(size) if telescope see back.
 - (5) screen 10', 415'
(length) (depth to top)
2", PVC
(size) (material)
 - (6) pump One, 14
(HP) (y/old gpm)
Electric
(type power)
 - (7) electric log no
(yes or no)
(organization running log)

(8) how well bottom plugged
2" back wash valve
DRILLERS REMARKS: 19-B


DEPT. OF NATURAL RESOURCES
BUREAU OF LAND & WATER RESOURCES

NOV - 5 1980

RECEIVED

If well telescopes please sketch and show depths.

GROUND LEVEL

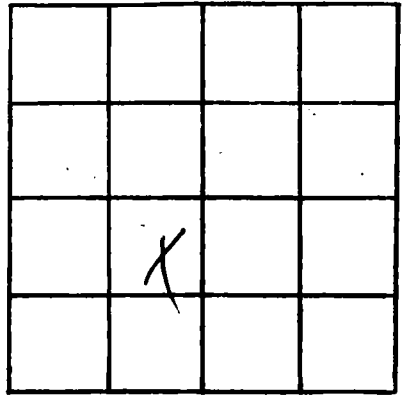

SECTION _____

Please indicate well location X.

ADDITIONAL INFORMATION

If more than one screen, show locations of each on sketch.