

HARRISON
M 2299

MISSISSIPPI
BOARD OF WATER COMMISSIONERS
416 North State Street
Jackson, Mississippi 39201

11-6-79

WATER WELL DRILLERS LOG

Nov. 6, 79

Switzer well Co.

HARRISON

date well completed

firm name

county well located

LANDOWNER: <u>David Lee</u>	description of formations encountered	from	to
(mailing address)			
WELL LOCATION: sec. <u>3</u> T. <u>7</u> N. R. <u>10</u> E <u>6</u> miles <u>NW</u> of <u>Biloxi</u> (distance) (direction) (nearest town)	CLAY	0	41
WELL PURPOSE: <u>Home</u> (home, irrigation, municipal, industrial)	Clay with sand streaks	41	69
WELL COMPLETION DATA:	CLAY	69	103
(1) diameter (inches) <u>2</u>	CLAY & shale	103	202
(2) total depth (feet) <u>333</u>	CLAY	202	237
(3) static water level (feet) <u>49</u> below above top of ground.	SAND	237	244
(4) casing <u>Steel</u> , <u>322</u> , (material) (depth) <u>2"</u> If telescope see back. (size)	CLAY	244	247
(5) screen <u>10'</u> , <u>323'</u> (length) (depth to top) <u>2"</u> <u>Stainless Steel</u> (size) (material)	SAND	247	249
(6) pump <u>owner</u> <u>1/2</u> (HP) (yield gpm)	CLAY	249	260
(type power)	CLAY & shale	260	280
(7) electric log _____ (yes or no)	CLAY	280	313
(organization running log)	SAND	313	332
(8) how well bottom plugged <u>Metal Backwash valve</u>			
DRILLERS REMARKS:			


DEPT. OF NATURAL RESOURCES
BUREAU OF LAND & WATER RESOURCES

DEC 20 1979

RECEIVED

If well telescopes please
sketch and show depths.

GROUND LEVEL

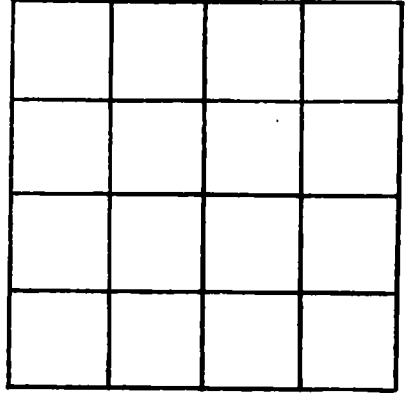

SECTION _____

Please indicate well location X.

ADDITIONAL INFORMATION

If more than one screen,
show locations of each on sketch.