

HARRISON
M 2301

MISSISSIPPI
BOARD OF WATER COMMISSIONERS
416 North State Street
Jackson, Mississippi 39201

WATER WELL DRILLERS LOG

3-21-80
March 21 1980
(date well completed) *Duncan Well Drilling Harrison*
firm name county well located

Robert Brown
LANDOWNER
117 Melissa
Biloxi, Ms.
(mailing address)

description of formations encountered	from	to
	sand	0

WELL LOCATION:
sec 17 T 7 N R 10 E
In town of Biloxi
(distance) (direction) (nearest town)

WELL PURPOSE: *irrigation*
(home, irrigation, municipal, industrial)

- WELL COMPLETION DATA:
- (1) diameter (inches) 2"
 - (2) total depth (feet) 30'
 - (3) static water level (feet) 0' ~~below~~ above top of ground.
 - (4) casing PVC, 20'
(material) (depth)
If telescope see back.
(size)
 - (5) screen 10' 20'
(length) (depth to top)
2" PVC
(size) (material)
 - (6) pump 1/2 14
(HP) (yield gpm)
electric
(type power)
 - (7) electric log
(yes or no)
 - (organization running log) Cap
 - (8) how well bottom plugged Cap

DEPT. OF NATURAL RESOURCES
BUREAU OF LAND & WATER RESOURCES


MAY 16 1980

RECEIVED

DRILLERS REMARKS:

If well telescopes please sketch and show depths.

GROUND LEVEL

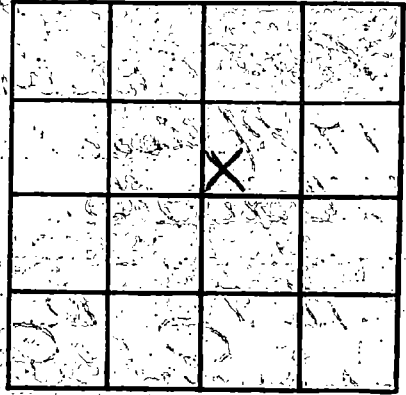

SECTION 17

Please indicate well location X.

ADDITIONAL INFORMATION

If more than one screen, show locations of each on sketch.