

HARRISON
M 2304
4-25-80

MISSISSIPPI
BOARD OF WATER COMMISSIONERS
416 North State Street
Jackson, Mississippi 39201

WATER WELL DRILLERS LOG

April 25 1980 *Sumner Well Drilling* *Harrison*
date well completed firm name county well located

LANDOWNER: *A. R. Hogg*
119 Melissa Dr.
Biloxi Ms.
(mailing address)

description of formations encountered	from	to
	<i>sand</i>	<i>0</i>

WELL LOCATION:
sec. *17* T. *7* N. R. *10*
In town of Biloxi
(distance) (direction) (nearest town)

WELL PURPOSE:
(home, irrigation, municipal, industrial)

WELL COMPLETION DATA:
(1) diameter (inches) *2"*
(2) total depth (feet) *30 ft.*
(3) static water level (feet) *2* below above top of ground.
(4) casing *PVC, 20'*
(material) (depth)
(size) if telescope see back.
(5) screen *10' 20'*
(length) (depth to top)
2" *PVC*
(size) (material)
(6) pump *1/2 14*
(HP) (yield gpm)
electric
(type power)
(7) electric log _____
(yes or no)
(organization running log) *Cap*
(8) how well bottom plugged

description of formations encountered	from	to
	<i>sand</i>	<i>0</i>

DEPT. OF NATURAL RESOURCES
BUREAU OF LAND & WATER RESOURCES


MAY 16 1980

RECEIVED

DRILLERS REMARKS:

If well telescopes please sketch and show depths.

GROUND LEVEL

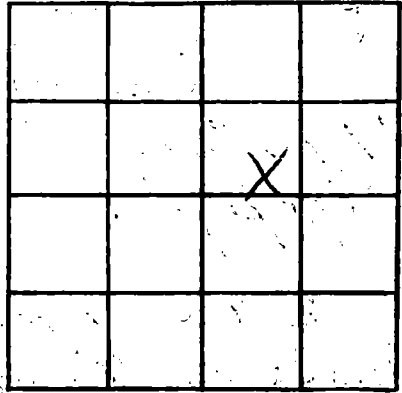

SECTION 17

Please indicate well location X.

ADDITIONAL INFORMATION

If more than one screen, show locations of each on sketch.