

MISSISSIPPI DEPARTMENT OF NATURAL RESOURCES

Bureau of Land and Water Resources

Southport Mall

P.O. Box 10631

Jackson, Mississippi 39209

WATER WELL DRILLERS LOG

HARRISON
M 2305
5/6/80

COASTAL DRILLING & SERVICE CO. *Harrison*

ROUTE # 1 BOX 618

date well completed

county well located

LANDOWNER

BILOXI

MISSISSIPPI 39522
depth of formations encountered

from to

Prof Royal
Pop Ferry Rd
Biloxi Min
(mailing address)

<i>top soil</i>	<i>1</i>	<i>3</i>
<i>Red Clay</i>	<i>3</i>	<i>25</i>
<i>Coarse white sand</i>	<i>25</i>	<i>60</i>
<i>Soft Blue Clay</i>	<i>60</i>	<i>210</i>
<i>fine water sand</i>	<i>210</i>	<i>240</i>
<i>Soft Blue Clay</i>	<i>240</i>	<i>360</i>
<i>hard Blue Clay</i>	<i>360</i>	<i>570</i>
<i>fine water sand</i>	<i>570</i>	<i>525</i>
<i>Coarse white sand</i>	<i>525</i>	<i>570</i>

WELL LOCATION:

sec. 5 T. 2 N. R. 9 E.
(3) Three miles North Biloxi
(distance) (direction) (nearest town)

WELL PURPOSE: *Domestic*
(home, irrigation, municipal, industrial)

WELL COMPLETION DATA:

- (1) diameter (inches) 2"
- (2) total depth (feet) 570'
- (3) static water level (feet) 65 below top of ground.
- (4) casing PVC 560'
(material) (depth)
- (size) if telescope see back.
- (5) screen 10' 560'
(length) (depth to top)
- 2" PVC
(size) (material)
- (6) pump One 10
(HP) (yield gpm)
- Ele
(type power)
- (7) electric log no
(yes or no)

(organization running log)

(8) how well bottom plugged 2" hard white sand

DRILLERS REMARKS: 19-B


DEPT. OF NATURAL RESOURCES
BUREAU OF LAND & WATER RESOURCES

NOV - 5/1980

RECEIVED

If well telescopes please sketch and show depths.

GROUND LEVEL

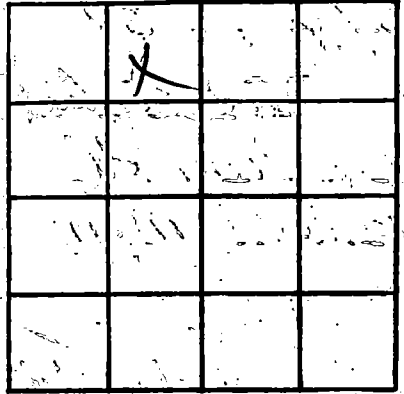

SECTION _____

Please indicate well location X.

ADDITIONAL INFORMATION

If more than one screen, show locations of each on sketch.

[Handwritten signature]
83-57