

HARRISON
 M. 2306
 5-12-80

MISSISSIPPI
 BOARD OF WATER COMMISSIONERS
 416 North State Street
 Jackson, Mississippi 39201
 WATER WELL DRILLERS LOG

5-12-1980 Bradon Pump + Harrison
 date well completed firm name county well located
 Well Service

LANDOWNER: Condon Walsh
 312 Bay Vista Drive
 Biloxi, MS
 (mailing address)

description of formations encountered	from	to
	0	10
	10	60

WELL LOCATION:
 sec. 27 T. 7 S. R. 10 E. W. 10
 miles 1.10 of Biloxi
 (distance) (direction) (nearest town)

WELL PURPOSE: home
 (home, irrigation, municipal, industrial)

- WELL COMPLETION DATA:
- (1) diameter (inches) 4"
 - (2) total depth (feet) 60
 - (3) static water level (feet) 15' below top of ground.
 - (4) casing PVC, total 4" (material), (depth) If telescope see back.
 - (5) screen 10' 50' (length), (depth to top) 4" PVC unobtainable (size), (material)
 - (6) pump 1 20 (HP), (yield gpm) 230 (type power)
 - (7) electric log NO (yes or no)
- (organization running log)

(8) how well bottom plugged
 2' below true value

DRILLERS REMARKS:
 notail pipe


MISSISSIPPI DEPT. OF NATURAL RESOURCES
 BUREAU OF LAND & WATER RESOURCES

JUN 25 1980

RECEIVED

If well telescopes please sketch and show depths.

GROUND LEVEL

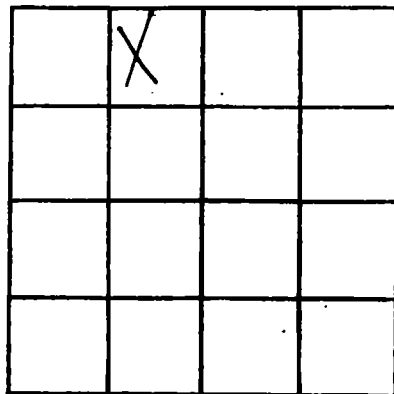

SECTION 27

Please indicate well location X.

ADDITIONAL INFORMATION

If more than one screen,
show locations of each on sketch.