

HARRISON

M 2308

5-23-80

MISSISSIPPI BOARD OF WATER COMMISSIONERS
416 North State Street
Jackson, Mississippi 39201

WATER WELL DRILLERS LOG

S-23
date well completed

1980 Braden Pump Well
firm name
See, Inc.

Harrison
county well located

LANDOWNER:
Shannon Trachessett
16105 QUAVE RD E.

Biloxi, MS
(mailing address)

description of formations encountered	from	to
Clay	0	258'
Sand	258'	280'

WELL LOCATION:
sec. 89 T. 7 S. R. 9 W.
miles in of Biloxi
(distance) (direction) (nearest town)

WELL PURPOSE: Home
(home, irrigation, municipal, industrial)

WELL COMPLETION DATA:

- (1) diameter (inches) 2"
- (2) total depth (feet) 280'
- (3) static water level (feet) 25' below top of ground
- (4) casing PVC total!
(material) (depth)
2" (size) if telescope see back.
- (5) screen 10' 270'
(length) (depth to top)
2" (size) PVC underlain (material)
- (6) pump 1/2 10
(HP) (yield gpm)
230 (type power)
- (7) electric log no
(yes or no)
(organization running log)

DEPT. OF NATURAL RESOURCES
BUREAU OF LAND & WATER RESOURCES

JUN - 2 1980


RECEIVED

(8) how well bottom plugged
2" sand shark

DRILLERS REMARKS:
No tail pipe

If well telescopes please sketch and show depths.

GROUND LEVEL

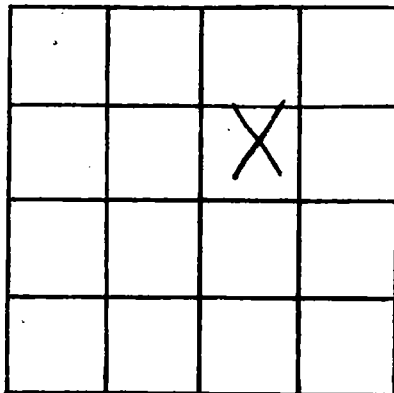

SECTION 9

Please indicate well location X.

ADDITIONAL INFORMATION

If more than one screen,
show locations of each on sketch.