

HARRISON

MISSISSIPPI  
BOARD OF WATER COMMISSIONERS  
416 North State Street  
Jackson, Mississippi 39201

M 2313

WATER WELL DRILLERS LOG

Lyman Well Co.

Harrison

6-19-80

6/19/80 19  
date well completed

firm name

county well located

LANDOWNER: R.D. Harrington  
742 Carter Dr.  
Gulfport, MS 39501  
(mailing address)

description of formations encountered

from to

White vegetation	0	9
Blue sand gravel	9	105
Sand grey silt	105	170
Blue clay	170	407
Sand sand	407	458

WELL LOCATION:

? sec 4 T 7 N R 10 E  
10 miles NW of Biloxi  
(distance) (direction) (nearest town)

WELL PURPOSE: home  
(home, irrigation, municipal, industrial)

WELL COMPLETION DATA:

- (1) diameter (inches) 2
- (2) total depth (feet) 458'
- (3) static water level (feet) 45' below top of ground
- (4) casing PVC 448' (material), (depth)  
2" (size) if telescope see back.
- (5) screen 10' 448' (length), (depth to top)  
2" 8 slot PVC (size), (material)
- (6) pump 1 12 (HP), (yield gpm)  
electric (type power)
- (7) electric log No (yes or no)  
No (organization running log)
- (8) how well bottom plugged sand  
shark

DEPT. OF NATURAL RESOURCES  
BUREAU OF LAND & WATER RESOURCES


JUN 26 1980

RECEIVED

DRILLERS REMARKS:

If well telescopes please sketch and show depths.

GROUND LEVEL

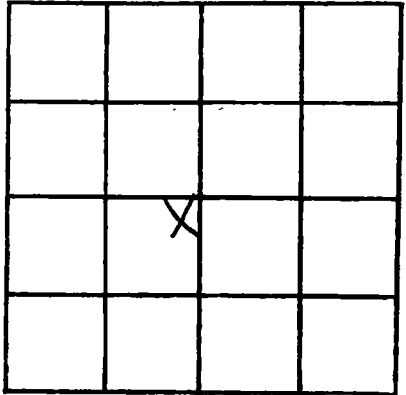

SECTION 4

Please indicate well location X.

ADDITIONAL INFORMATION

A series of horizontal lines for writing additional information.

If more than one screen, show locations of each on sketch.