

MISSISSIPPI DEPARTMENT OF NATURAL RESOURCES

Bureau of Land and Water Resources

Southport Mall

P.O. Box 10631

Jackson, Mississippi 39209

WATER WELL DRILLERS LOG

COASTAL DRILLING & SERVICE CO.

HARRISON
M 2314

7-4-80

7/4/80 19

date well completed

ROUTE 1 BOX 618

county well located

LANDOWNER

Henry Hugh

Hay Rd

Biloxi Min

(mailing address)

BILOXI, MISS. 39532

description of formations encountered

from to

Top Soil	1	3
Red Clay	3	35
Green Sand	35	60
Soft Blue Clay	60	160
fine water sand	160	185
Soft Blue Clay	85	310
fine water sand	310	345
(hard)	345	350
hard Blue Clay	350	490
fine water sand	490	540
hard Blue Clay	540	740
fine water sand	740	760
Round water sand	760	790

WELL LOCATION:

sec. 5 T. 7 N R. 9 E

(3) Three miles North Biloxi (distance) (direction) (nearest town)

WELL PURPOSE:

(home, irrigation, municipal, industrial)

home

WELL COMPLETION DATA:

- (1) diameter (inches) 2"
- (2) total depth (feet) 790'
- (3) static water level (feet) 20' below top of ground.
- (4) casing PVC, 775' (material) (depth)
- (size) if telescope see back.
- (5) screen 15', 775' (length) (depth to top)
- 2" PVC (size) (material)
- (6) pump One 12 (HP) (yield gpm)
- Ele (type power)
- (7) electric log 2W (yes or no)

(organization running log)

(8) has well bottom plugged

2 inch water stand


DRILLERS REMARKS:

19-B

RECEIVED

If well telescopes please sketch and show depths.

GROUND LEVEL

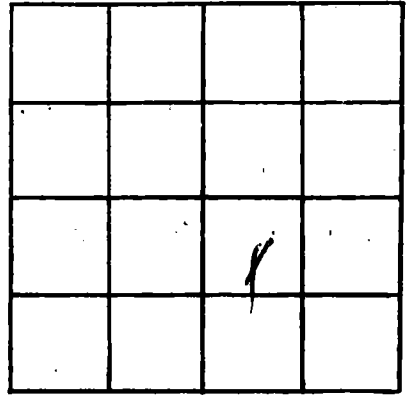

SECTION _____

Please indicate well location X.

ADDITIONAL INFORMATION

If more than one screen, show locations of each on sketch.