

MISSISSIPPI DEPARTMENT OF NATURAL RESOURCES

Bureau of Land and Water Resources

Southport Mall

P.O. Box 10631

Jackson, Mississippi 39209

WATER WELL DRILLERS LOG
COASTAL DRILLING & SERVICE CO.

ROUTE 1 BOX 618

firm name
BLOOM, MISS. 39532

county well located

HARRISON
M 2319
7-30-80

date well completed

LANDOWNER: Woodbury

description of formations encountered

from to

St 1 woodward
Bible's Inn
(mailing address)

top soil	1	3
red clay	3	15
white sand	15	35
soft blue clay	35	230
hard blue clay	230	305
fine water sand	305	365
good water sand	365	330

WELL LOCATION:

sec. 4 T. 7 N. R. 10 E
S W

Coalington miles of (distance) W (direction) of (nearest town)

WELL PURPOSE:

(home, irrigation, municipal, industrial)

WELL COMPLETION DATA:

- (1) diameter (inches) 2"
- (2) total depth (feet) 330'
- (3) static water level (feet) 40' below above top of ground.
- (4) casing PVC 320' (material) (depth)

(size) If telescope see back.

- (5) screen 10' 320' (length) (depth to top)
- 2" (size) PVC (material)

- (6) pump One 12 (HP) (yield gpm)
- Electric (type power)

- (7) electric log no (yes or no)

(organization running log)

- (8) boy well, bottom plugged 2 inch well

DRILLERS REMARKS:


DEPT. OF NATURAL RESOURCES
BUREAU OF LAND & WATER RESOURCES

JAN 23 1981

RECEIVED

If well telescopes please sketch and show depths.

GROUND LEVEL

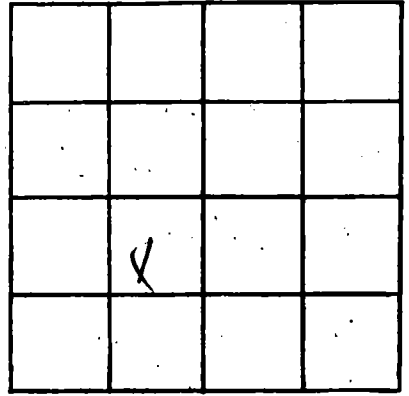

SECTION _____

Please indicate well location X.

ADDITIONAL INFORMATION

If more than one screen, show locations of each on sketch.